


T.18S. R.2W. W.M.

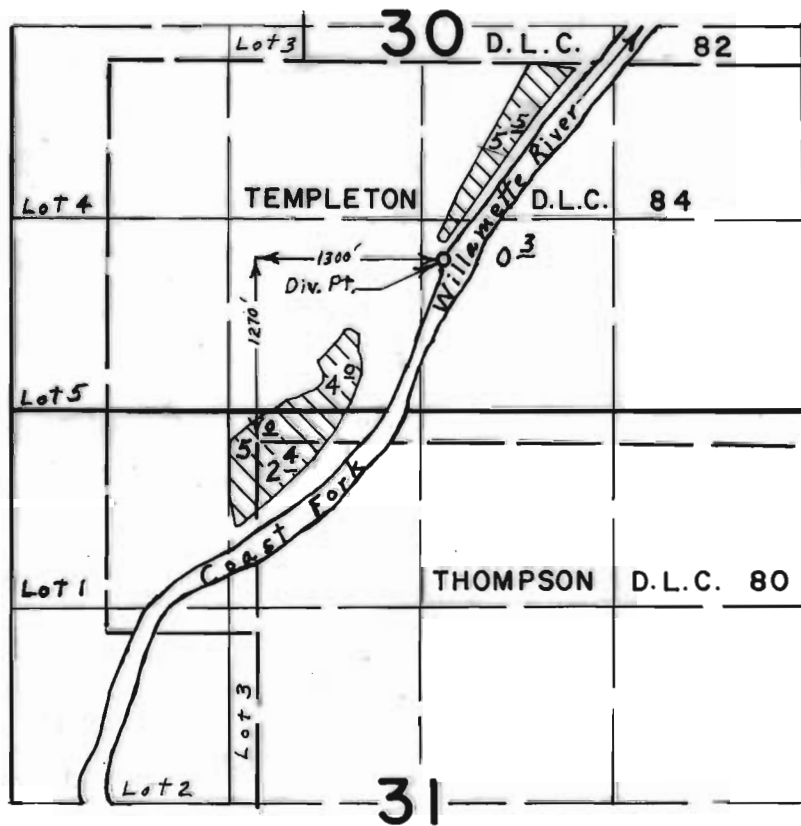

**FINAL PROOF SURVEY**  
UNDER

Application No. 47469 Permit No. 35558  
IN NAME OF

**EHRMAN V. GIUSTINA**

Surveyed June 23, 1976, by L. E. Gould