


# T.6S.,R.10W.,W.M.

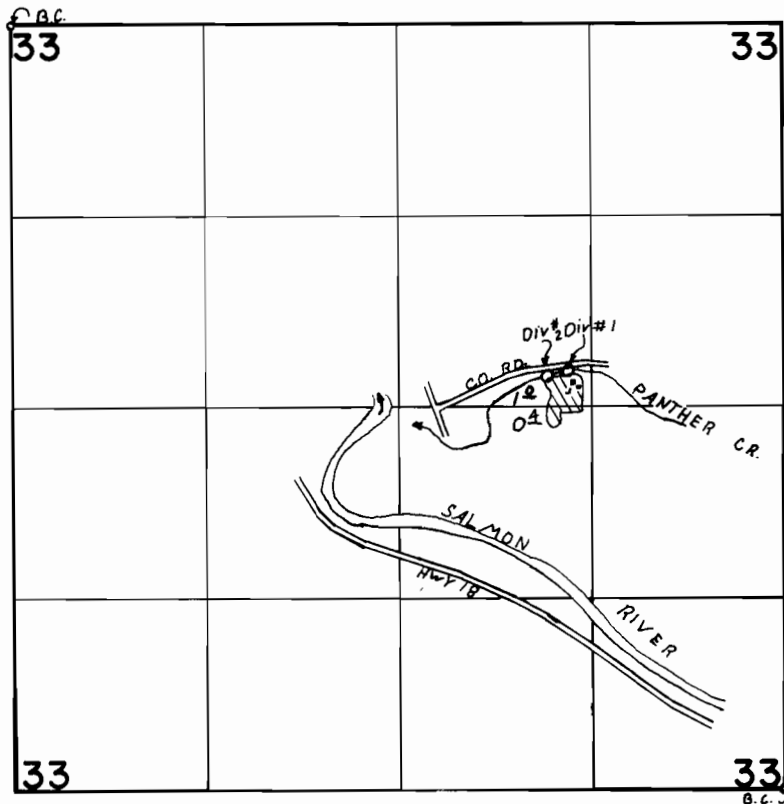

DIV #1: 2940' N & 1450' W FROM THE SE COR SEC 33  
DIV #2: 2900' N & 1590' W " " " " " "

## FINAL PROOF SURVEY UNDER

Application No. 48888 Permit No. 36627  
IN NAME OF

CLAUDE W. & GEORGIA H. SAVAGE

Surveyed JUNE 29 1976, by C.R. KING