


T.6S.,R.10W.,W.M.

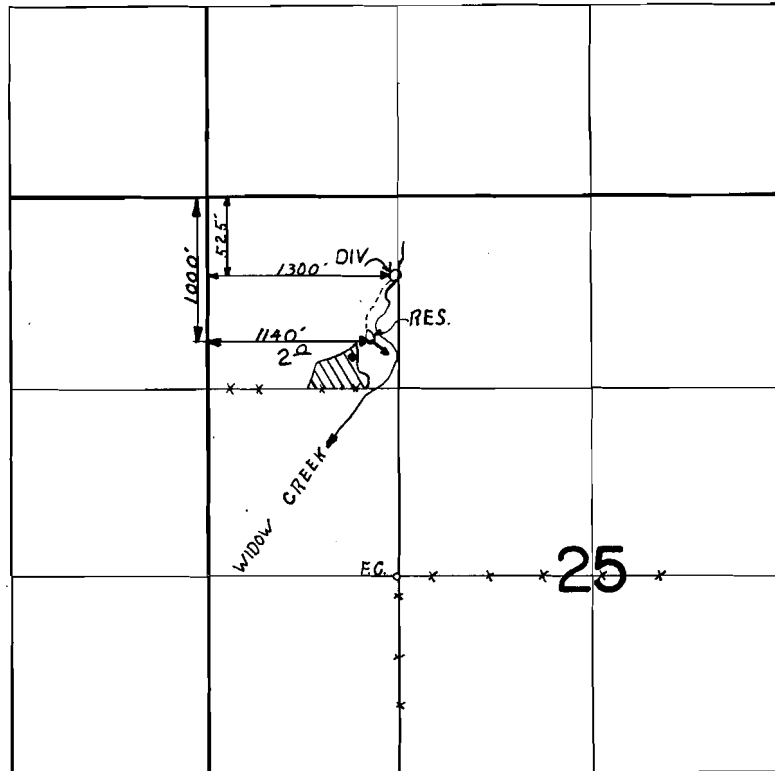

FINAL PROOF SURVEY
UNDER

Application No. R-49386 49387 Permit No. R-5857 36158
IN NAME OF

JOHN F. HAMEL

Surveyed June 28 1976, by C.R. KING