


T.6S.,R.10W.,W.M.

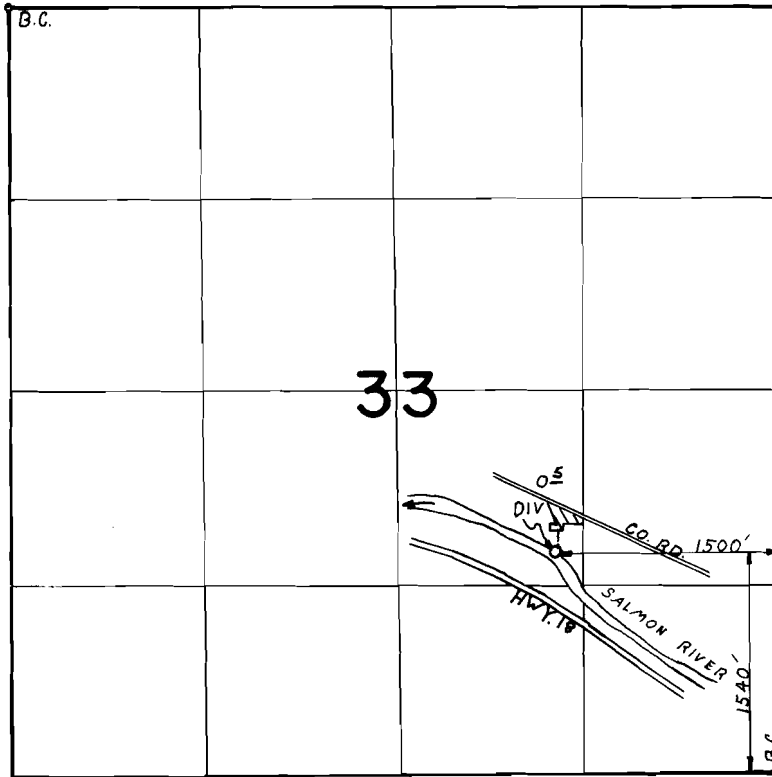

**FINAL PROOF SURVEY**  
UNDER

Application No. 49965 Permit No. 37586  
IN NAME OF

ELMER L. GARBUTT

Surveyed JUNE 29 1976, by G.R. KING