


T.6S.,R.10W.,W.M.

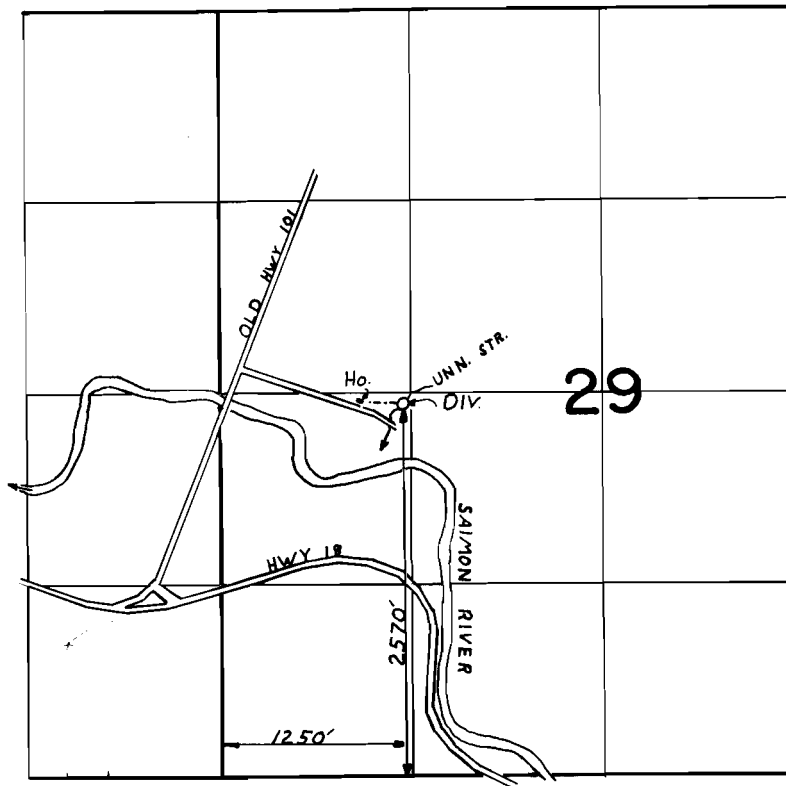

FINAL PROOF SURVEY
UNDER

Application No. 50288 Permit No. 37377
IN NAME OF

GAYTON R. & DORIS E. PHELPS

Surveyed JUNE 29 1976, by C.R. KING