


T. 30S.R.46E.W.M.

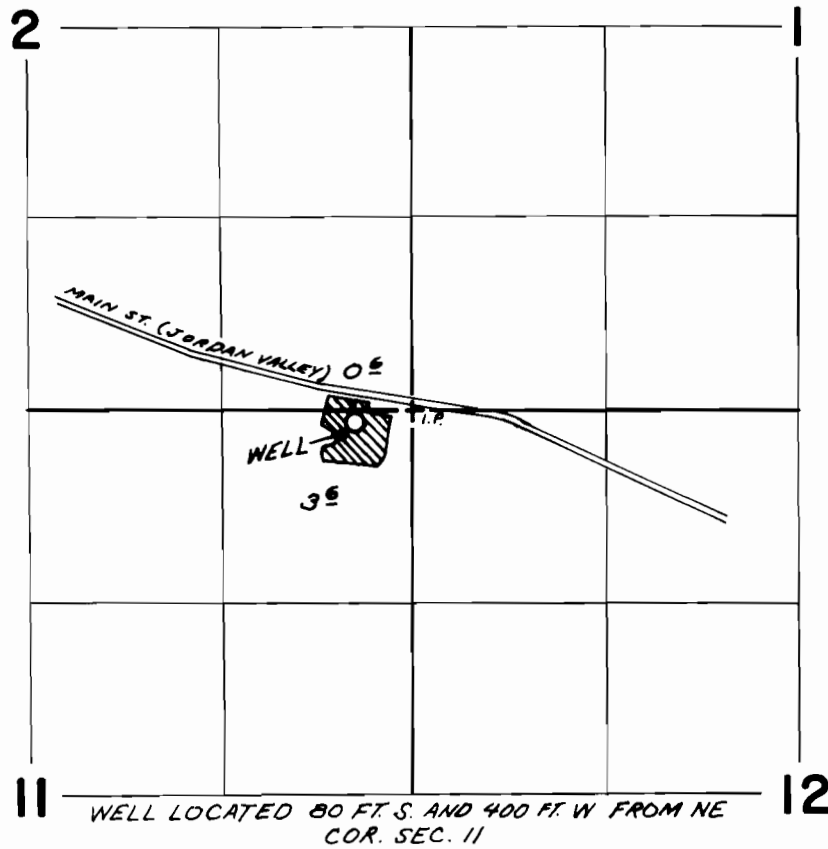

FINAL PROOF SURVEY
UNDER

Application No. G-6164 Permit No. G-5847

ESTATE OF IN NAME OF

W. E. LOVELAND

Surveyed JUN 11 1976, by L. E. GOULD