


T.32S., R.40&41E., W.M.

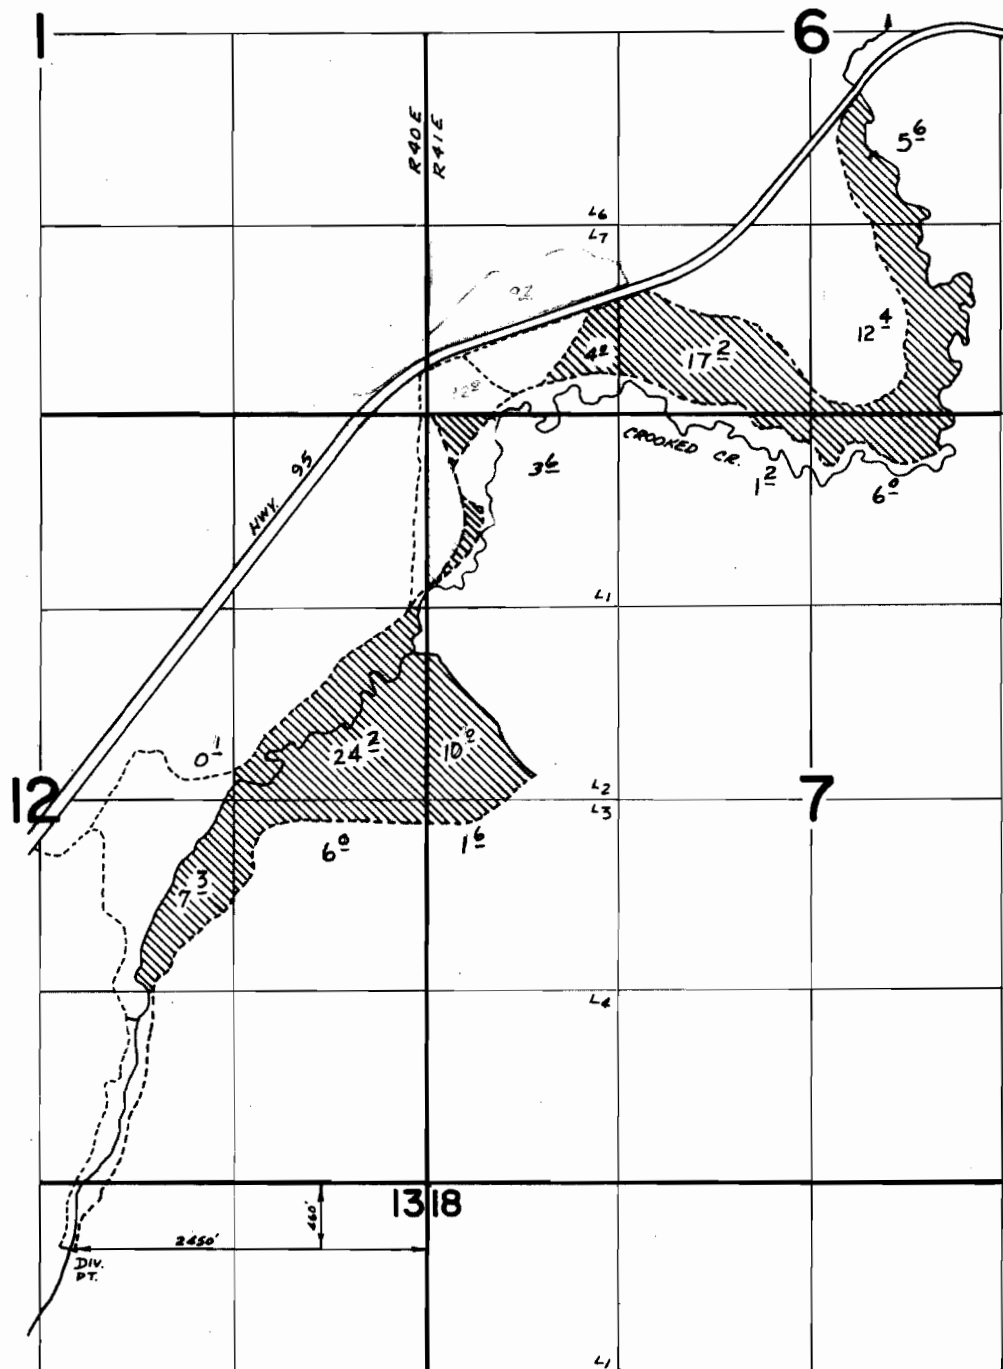

**FINAL PROOF SURVEY
UNDER**

Application No. 42531 Permit No. 31782
IN NAME OF

JULIAN ZIMMERMAN

Surveyed: July 14, 1975 by: D. Norby