


T.30S. R.44E W.M.

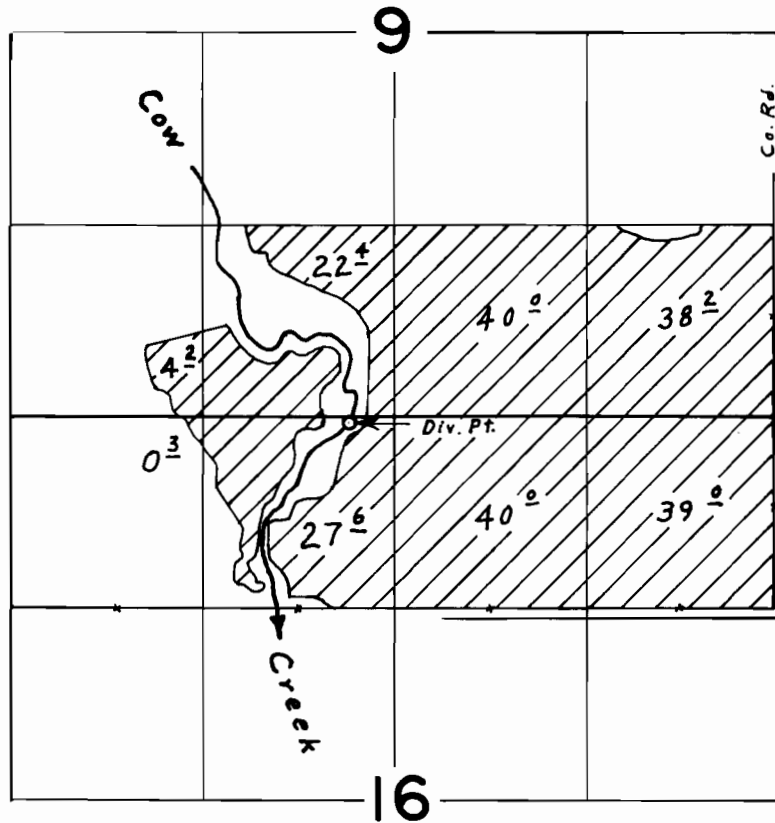

Div. Pt. located 40' S. & 2940' W. from N.E. Cor. Sec. 16

FINAL PROOF SURVEY UNDER

Application No. 43319... Permit No. 31930
IN NAME OF

DUARD W. TERRY

.....
June 14, 1976 L. E. Gould
Surveyed Oct. 29, 1968, by V. Garner.....