


T.18S., R.46E., W.M.

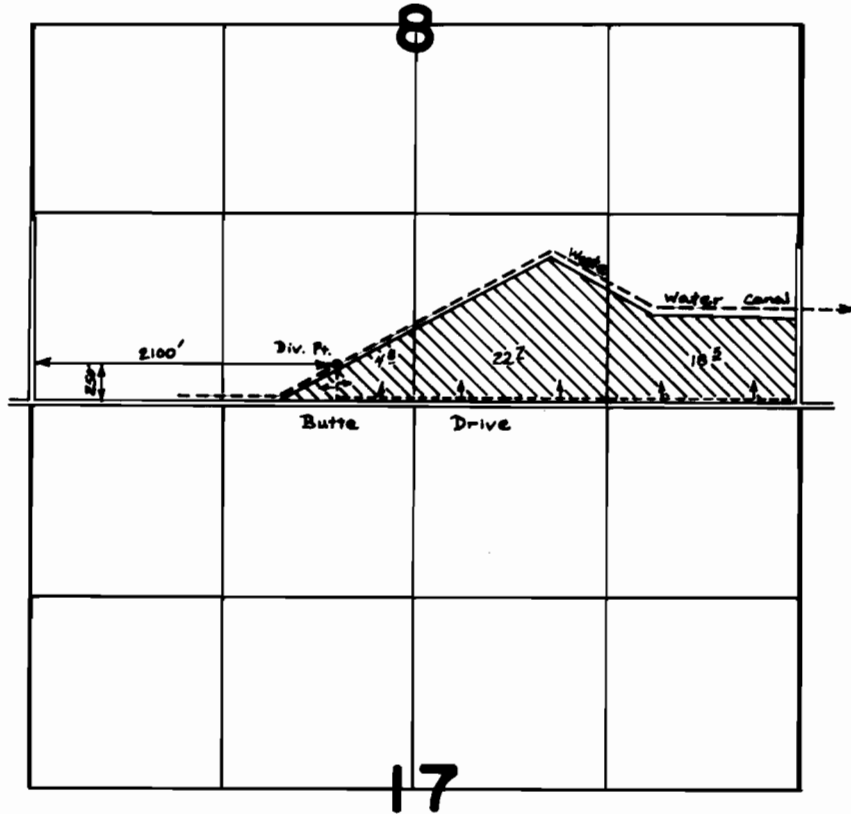

FINAL PROOF SURVEY
UNDER

Application No. 49131 Permit No. 36841
IN NAME OF

ARDTH HUFFAKER

Surveyed OCT. 14 1977, by J.S. DONALDSON