


Township 18, S., Range 45, E. W. M.

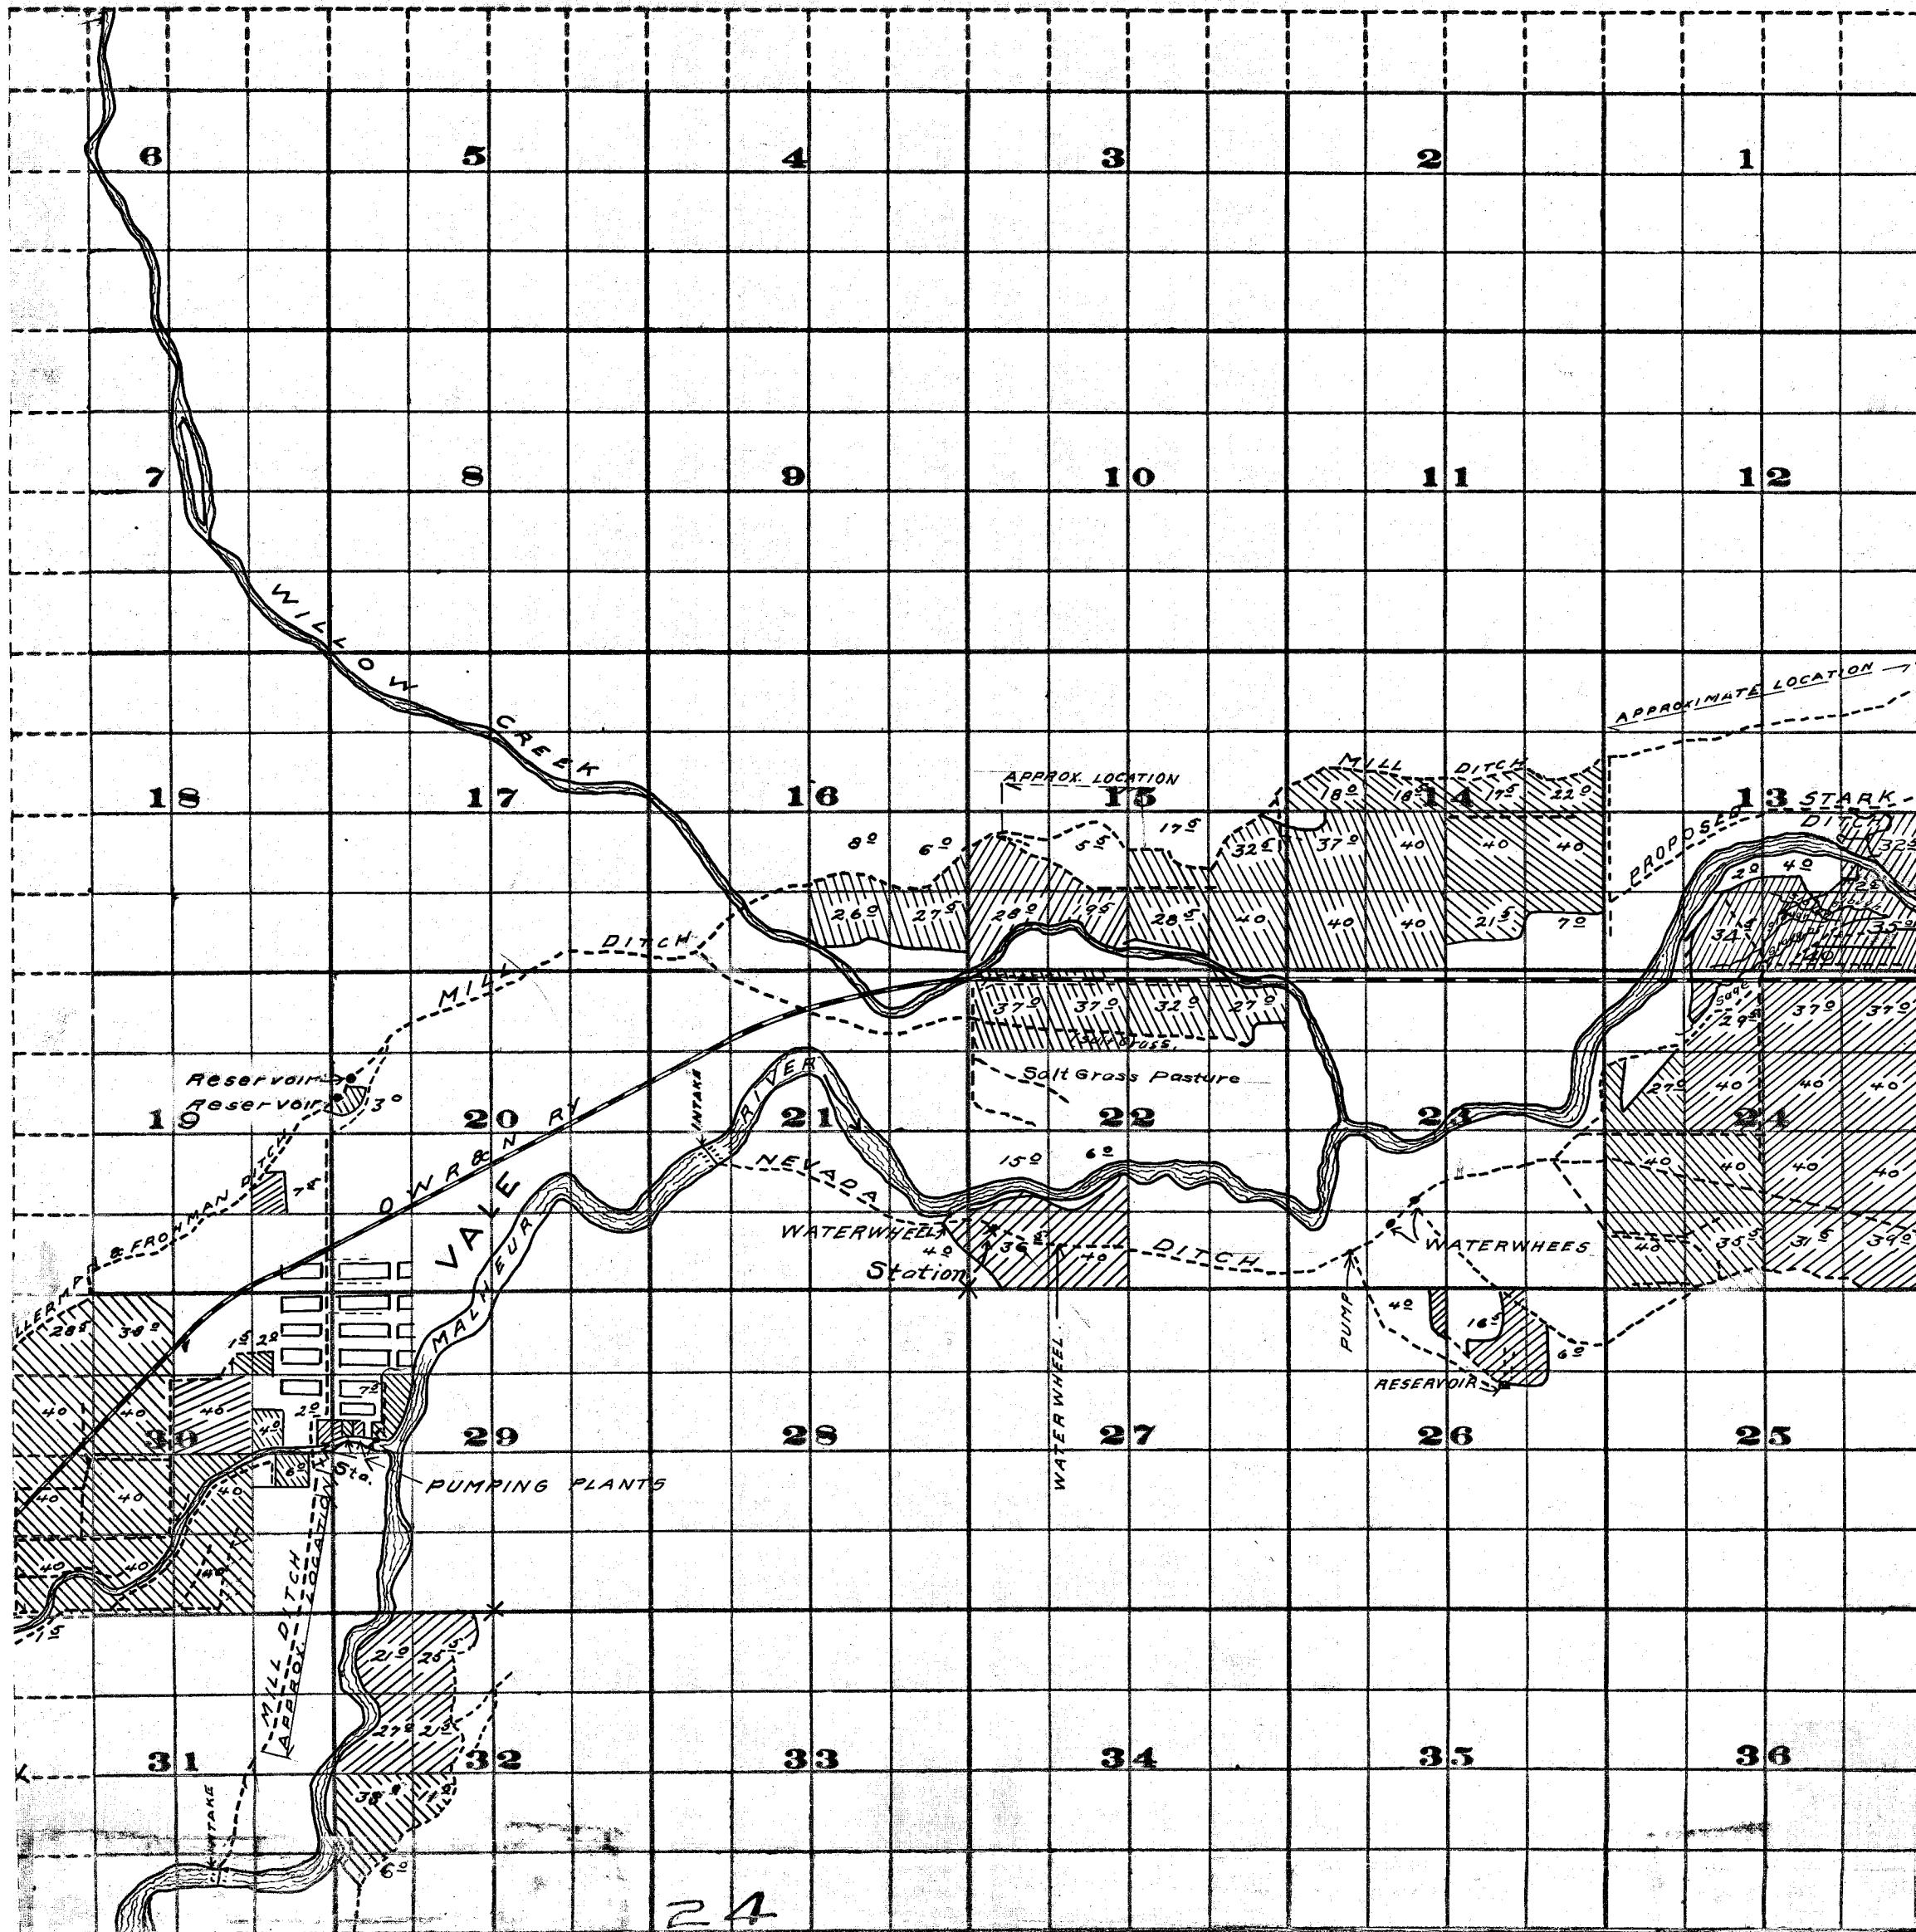

Scale of Feet.  
— LEGEND —

Survey Aug. 1913

FROM OFFICE OF THE STATE ENGINEER, SALEM, OREGON

Adjudication Survey  
Malheur River  
and  
Tributaries

- Irrigated land with area
- Streams.
- Ditches.
- Located corners.