


T4S. R.IW. W.M.

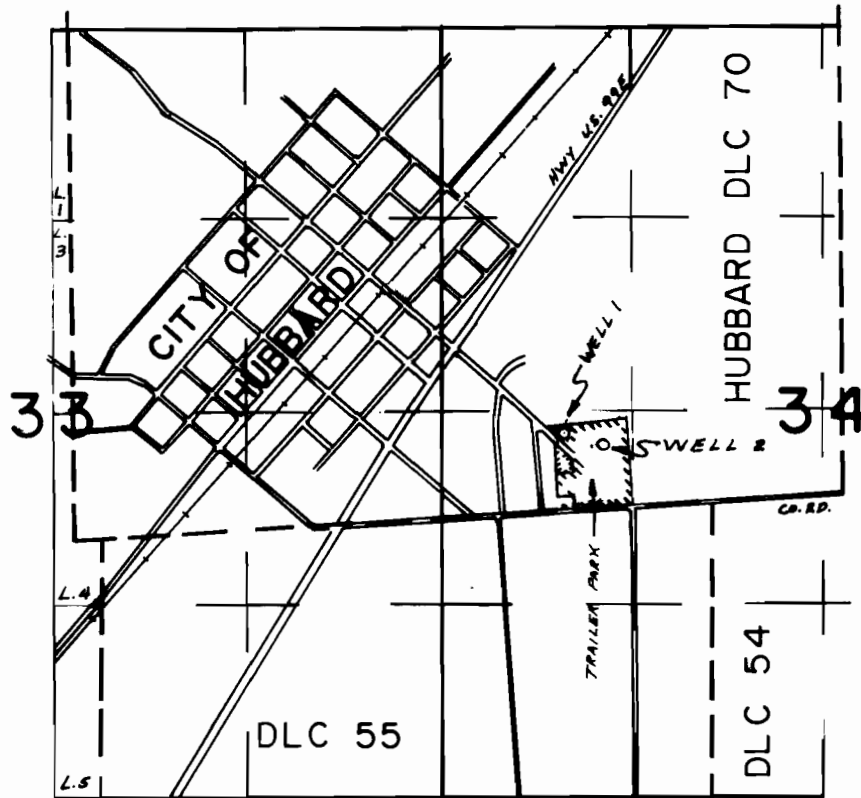

WELL 1 LOC. 400' N. & 1910' W., WELL 2 LOC. 320' N. & 1640' W., BOTH FROM SE COR., HUBBARD DLC 70

FINAL PROOF SURVEY UNDER

Application No. G-5916 Permit No. G-7722
G-4975 G-4693

IN NAME OF

MARTHA E. OLSON ZACH

Surveyed SEP. 23. 1974., by L.H. NUNN