


T.5S.,R.1&2W.,W.M.

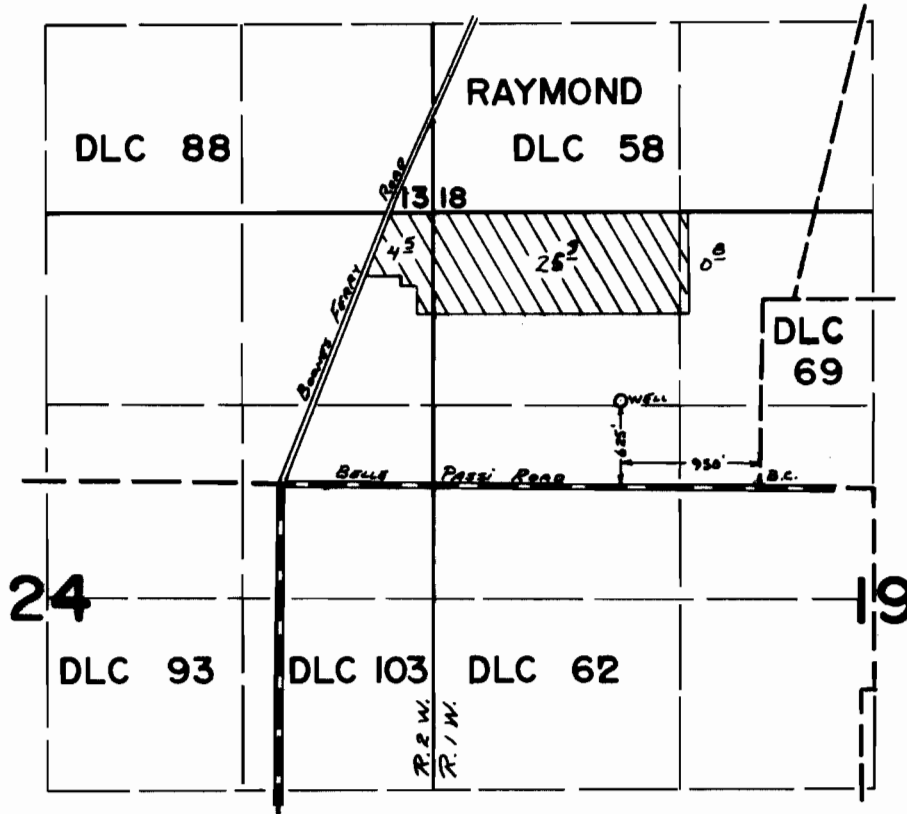

FINAL PROOF SURVEY UNDER

Application No. G-5479 Permit No. G-5384
IN NAME OF

GLEN E. SCHWENKE

Surveyed Oct. 1, 1975, by L. Tall