


# T4S. R.IW. W.M.

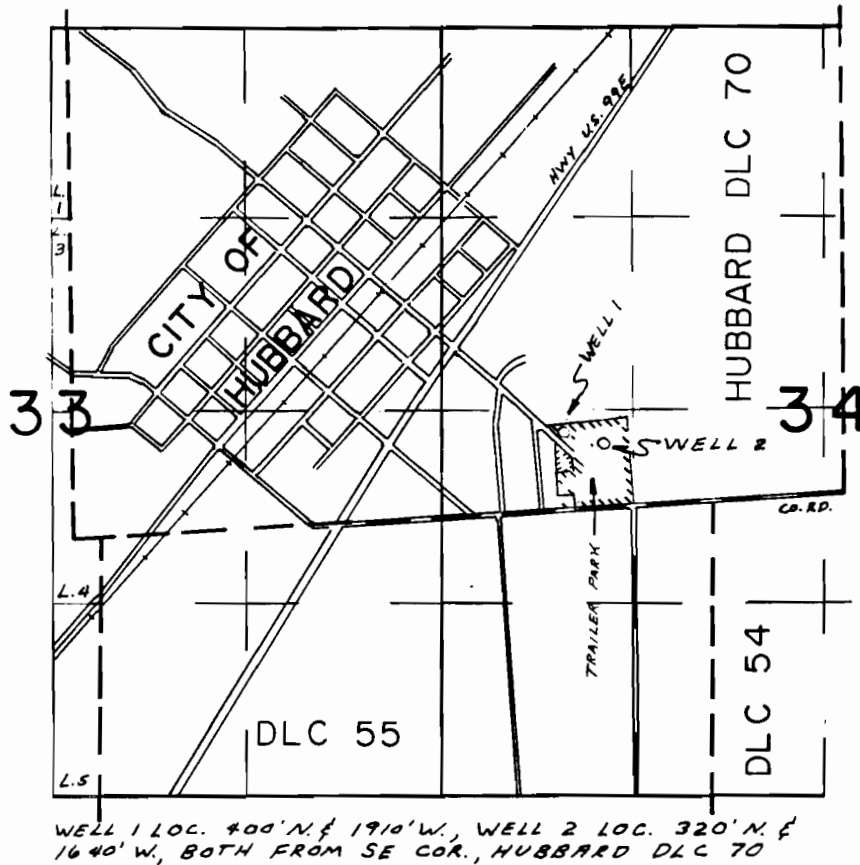

## FINAL PROOF SURVEY UNDER

Application No. G-5916 G-7722  
G-4975 Permit No. G-4693

IN NAME OF

MARTHA E. OLSON ZACH

Surveyed SEP. 23. 1974. by L.H. NUNN