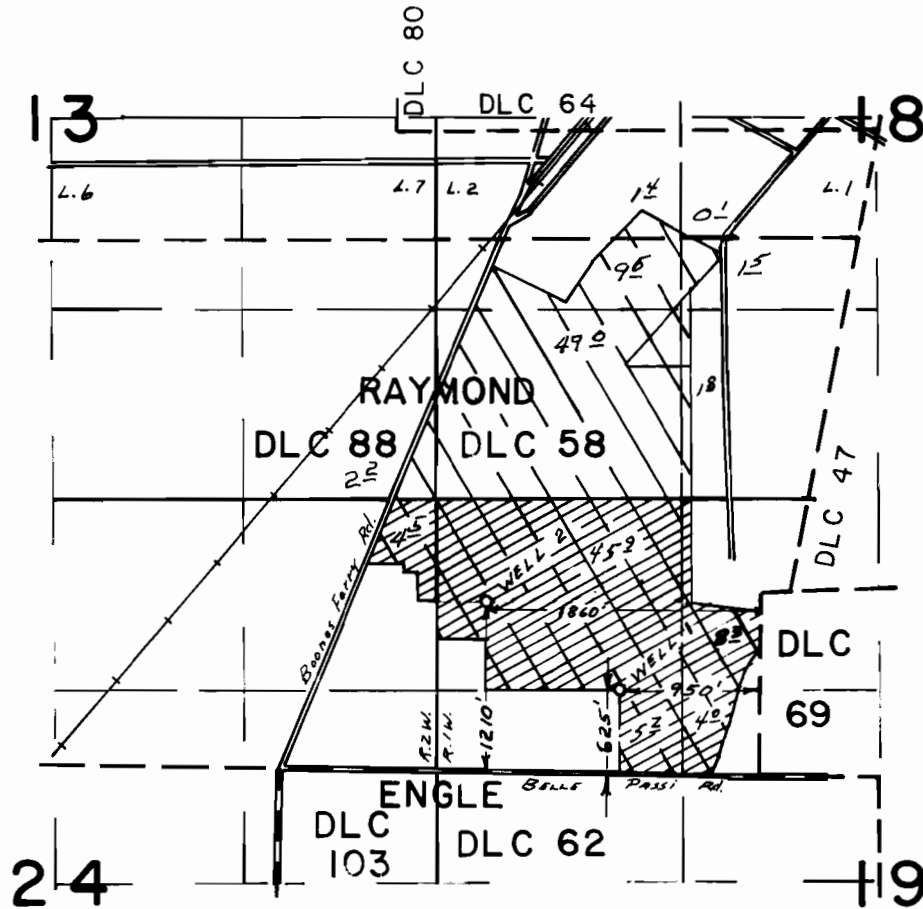

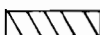


T.5S. R.1 & 2W. W.M.



 SUPPL.
 PRIMARY

FINAL PROOF SURVEY UNDER

Application No. G-6702... Permit No. G-6246...
IN NAME OF

GLEN E. SCHWENKE

Surveyed NOV. 9 1977, by L.H. NUNN