


# T.8S.,R.IE.,W.M.

*Handwritten notes:*  
 11/20/74  
 - 11/20/74  
 46525

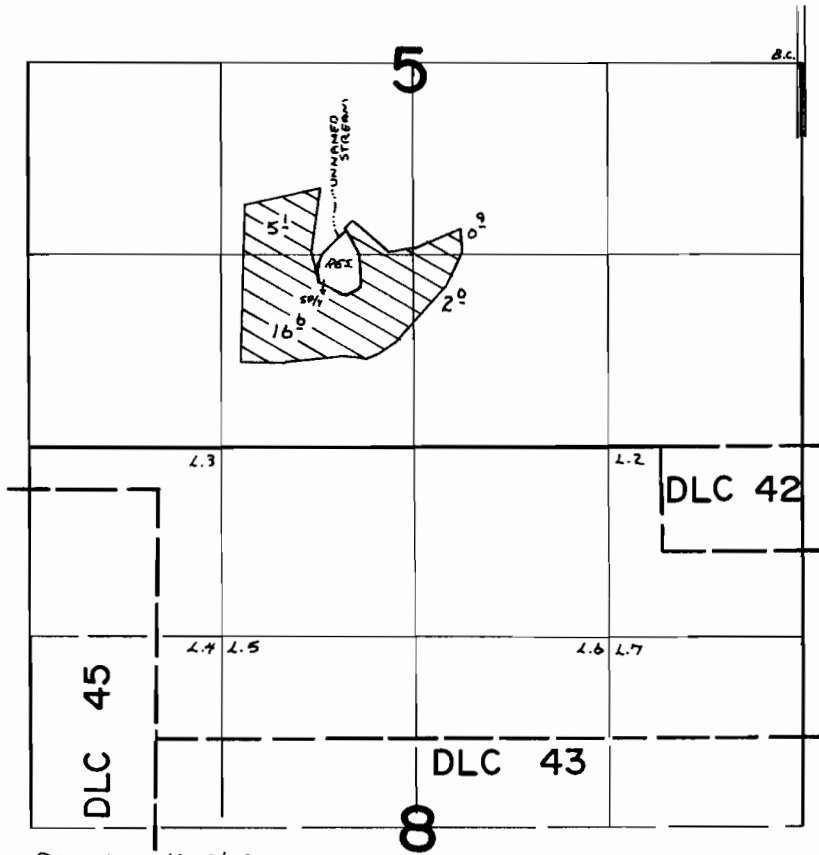

DAM LOC: 1600' S AND 3140' W FROM E 1/4 COR SEC. 5

## FINAL PROOF SURVEY UNDER

Application No. R-46524 46525 Permit No. R-5548 34759  
 IN NAME OF

GOLDIE MARCOTT

Surveyed MAY 31 1974 by L. H. NUNN  
SEPT 2 1975 L. TOLL