


T.6 S. R.2W.W.M.

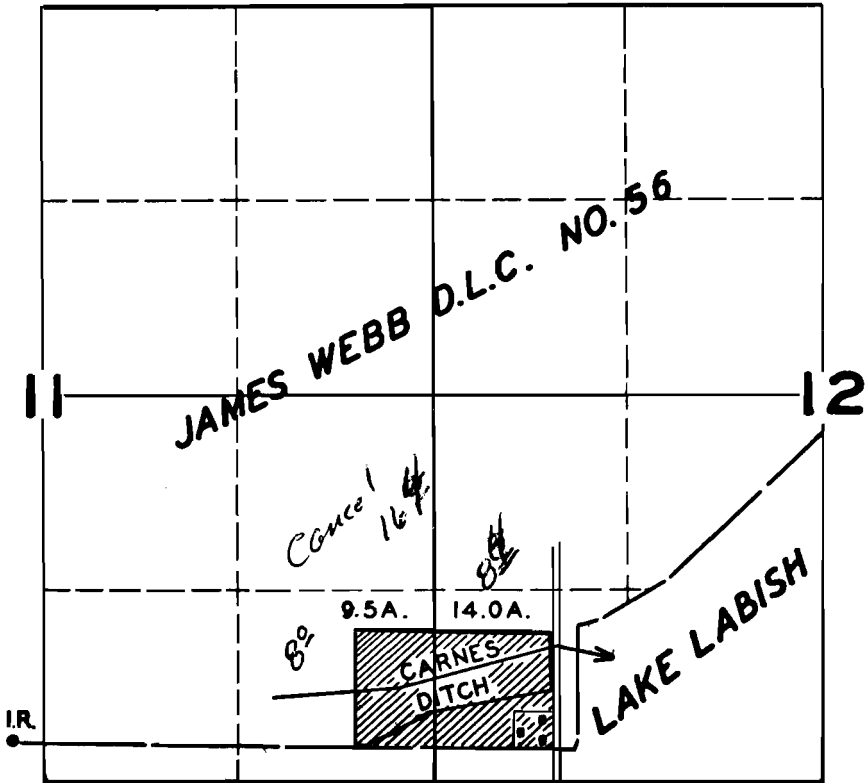

FINAL PROOF SURVEY UNDER

Application No. ~~15839~~ Permit No. ~~11688~~
IN NAME OF

ERNEST L. DUNN

Surveyed APR. 29 1949, by JAS. E. BUNNELL