


T.8S., R.5W., W.M.

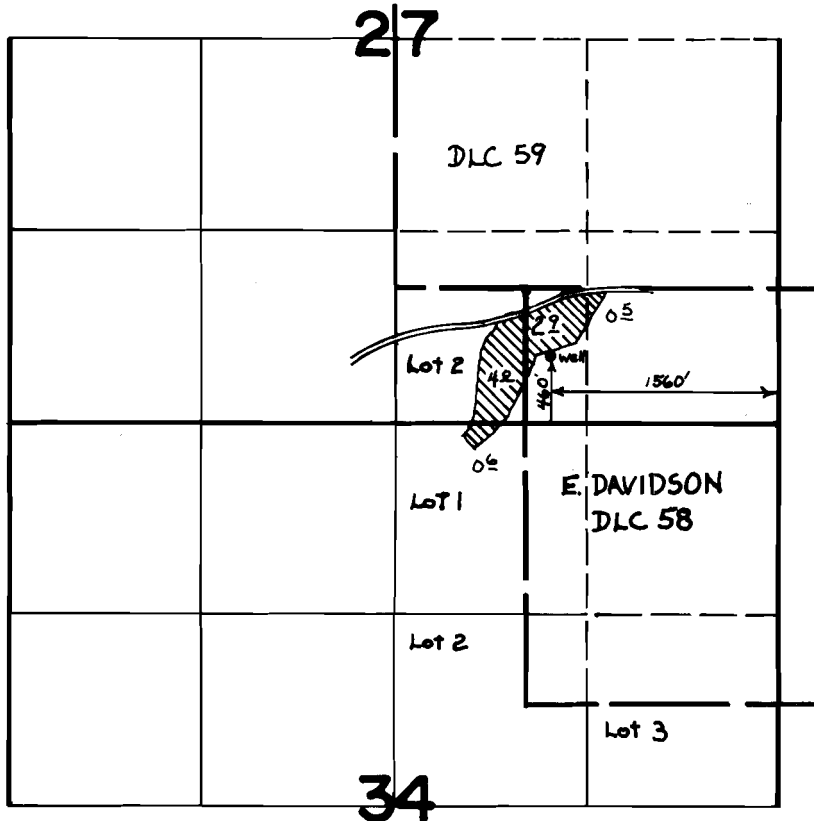

FINAL PROOF SURVEY
UNDER

Application No. G-5388 Permit No. G-5317
IN NAME OF

KENNETH H. LENHARD

Surveyed AUG. 12 1976, by C. KING