


T. 8 S., R. 4 W., W.M.

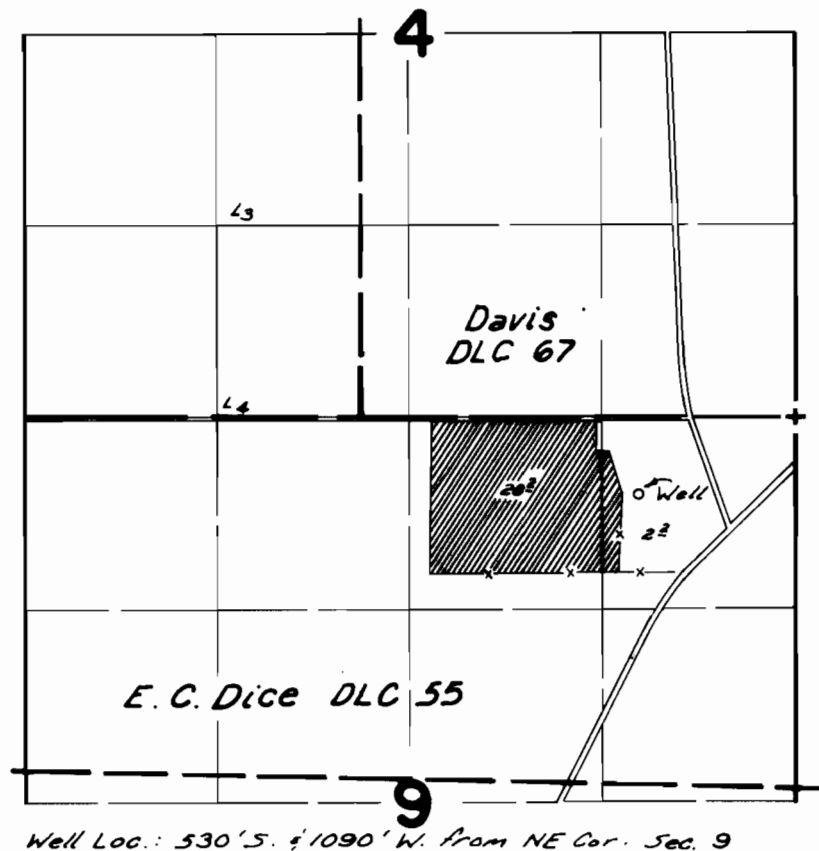

FINAL PROOF SURVEY UNDER

Application No. G-6210 Permit No. G-5868
IN NAME OF

David J. Knaupp

Surveyed June 4, 1976 by C.R. King