


# T.6S., R.7W., W.M.

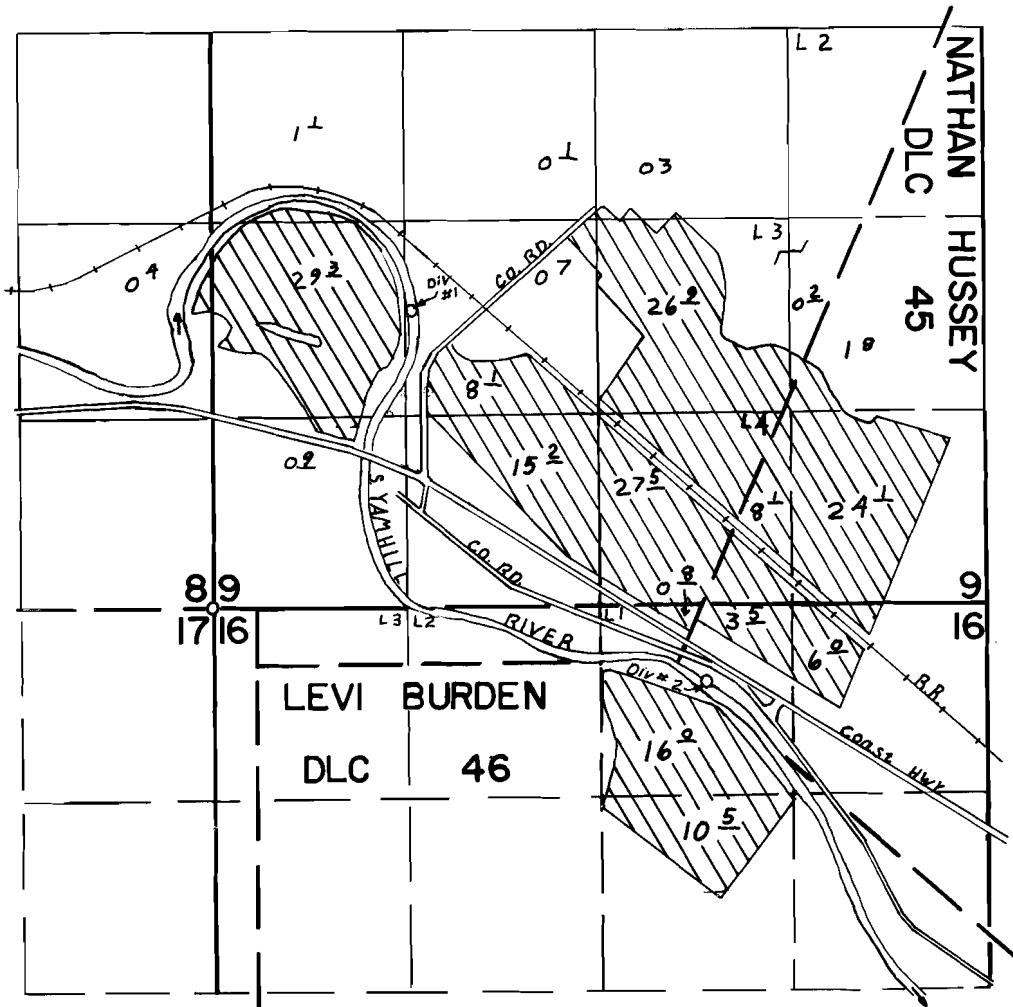

DIV #1 2010N & 1380E FROM SW COR SEC 9  
 DIV #2 510S & 3425E FROM SW COR SEC 9

## FINAL PROOF SURVEY UNDER

Application No. 48363 Permit No. 36310  
 IN NAME OF

WESLEY E. SHENK

Surveyed AUG 10 1976, by C.R. KING