


T.6S.,R.7&8W.,W.M.

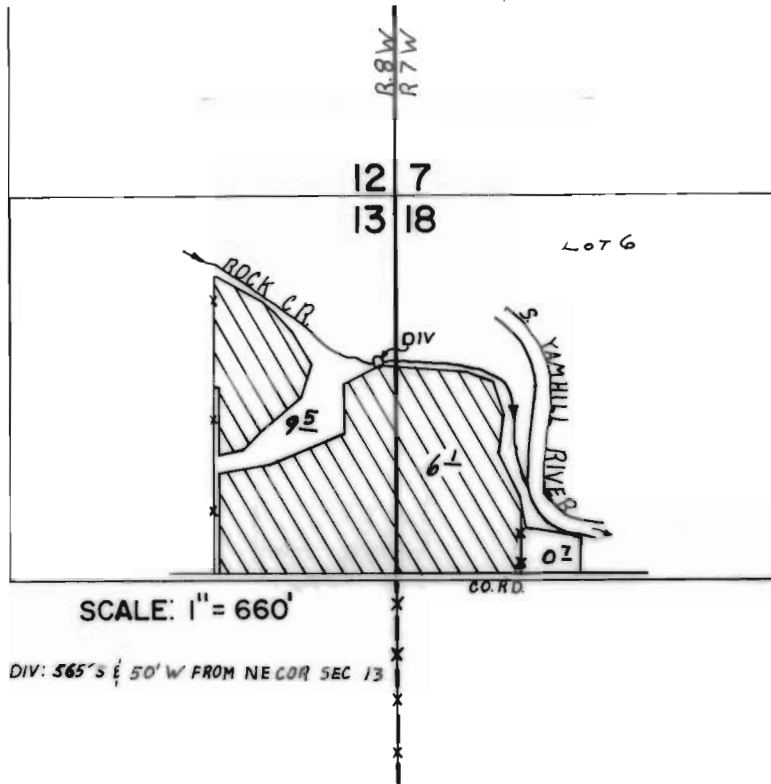

FINAL PROOF SURVEY
UNDER

Application No. 49442 Permit No. 36946
IN NAME OF

JOHN G. SWOYER

Surveyed AUG. 11. 1976., by C.R. KING