


T.8S., R.6W., W.M.

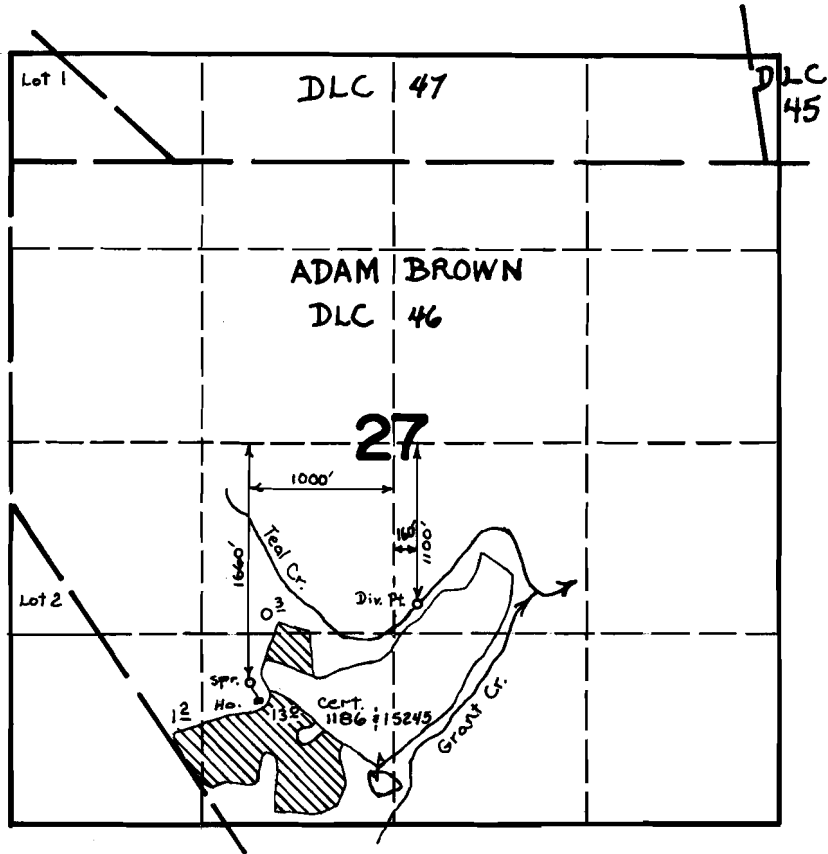

FINAL PROOF SURVEY
UNDER

Application No. 50446 Permit No. 38101
IN NAME OF

DONALD L. KING

Surveyed OCT. 7 1976, by C.R. KING