


# T.9S., R.5 W., W.M.

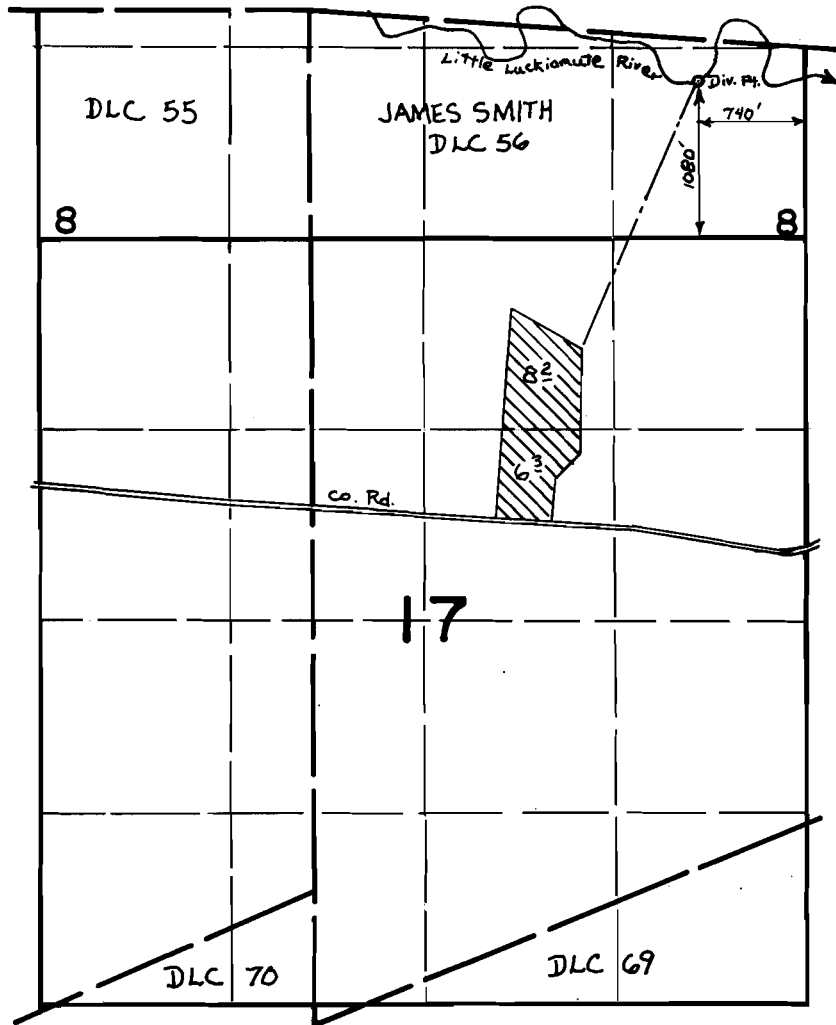

## FINAL PROOF SURVEY UNDER

Application No. 50564 Permit No. 38176  
IN NAME OF

WAYNE OSBORN

Surveyed JULY 8 1976, by C. R. KING