




T. 7 S. R. 5 & 6 W. W.M.

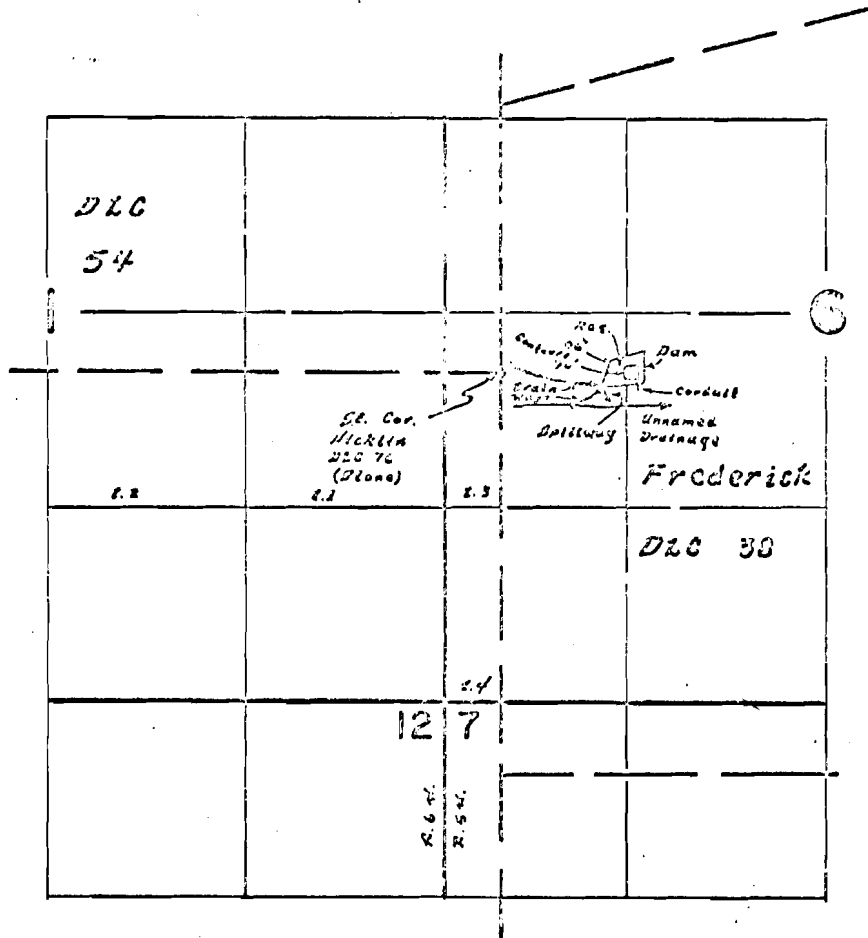

R.O.D. on Northernly Drainage & Dam 300. 60° S. & 920° E. from S.E. Cor. Nicklin 220 76  
 R.O.D. on Southernly Drainage way Located 200ft. S. & 475ft. E. from S.E. Corner of Nicklin 220 76

**FINAL PROOF SURVEY**  
 UNDER

**RECORDED**  
 JUN 5 1973

Application No. R-46082 Permit No. R-5482 STATE ENGINEER  
 IN NAME OF SALEM, OREGON  
 Alvin Acbi

Surveyed 1 Sept 1972, by J.E. Gould

Application No. R-50600 & 50621  
 Permit No. R-6000 30252  
 J.E. Gould