


T. 7 S. R. 5 & 6 W. W.M.

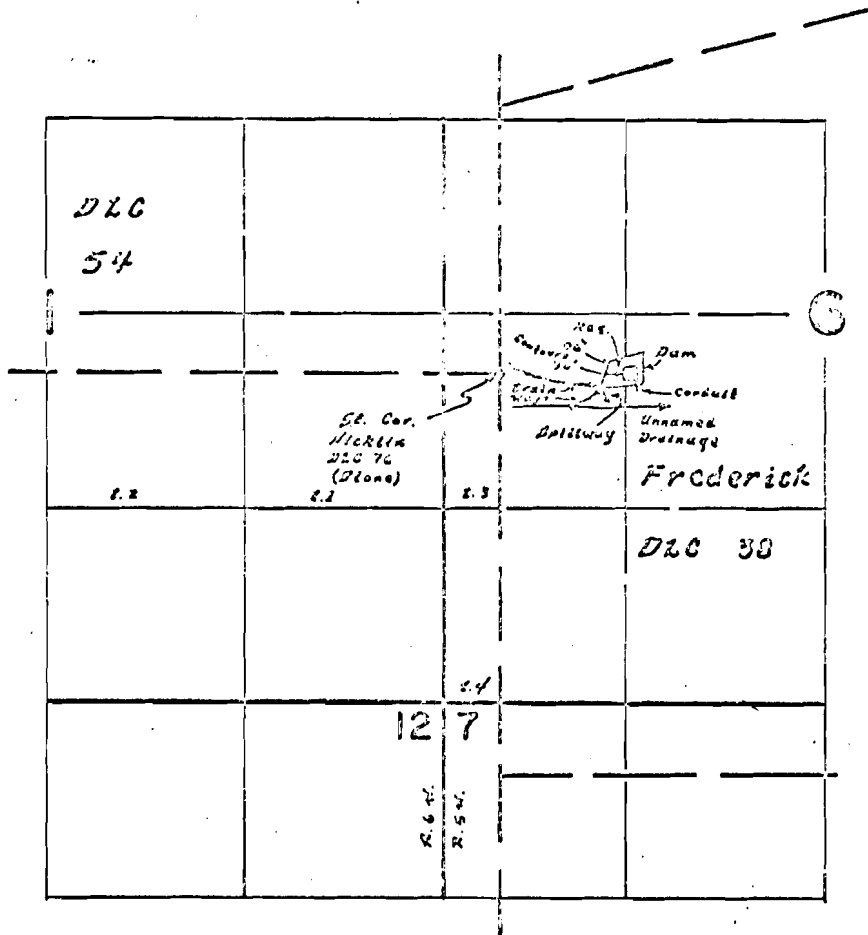

P.O.D. on Northern Drainage & Dam 300. 60' N. & 920' E. from S.E. Cor. Nicklin DLC 76
 P.O.D. on Southern Drainage way located 200ft S. & 475ft E. from S.E. Corner of Nicklin DLC 76

FINAL PROOF SURVEY
 UNDER

RECORDED
 JUN 9 1972

Application No. *R-46002* Permit No. *R-5482*
 IN NAME OF
Alvin Acobi

STATE ENGINEER
 SALEM, OREGON

Surveyed *1. Sept 1972*, by *J.E. Gould*

Application No. *R-50600 & 50621*
 Permit No. *R 6000*
 1972. U. DEPT