


T. 7S., R. 4W., W.M.

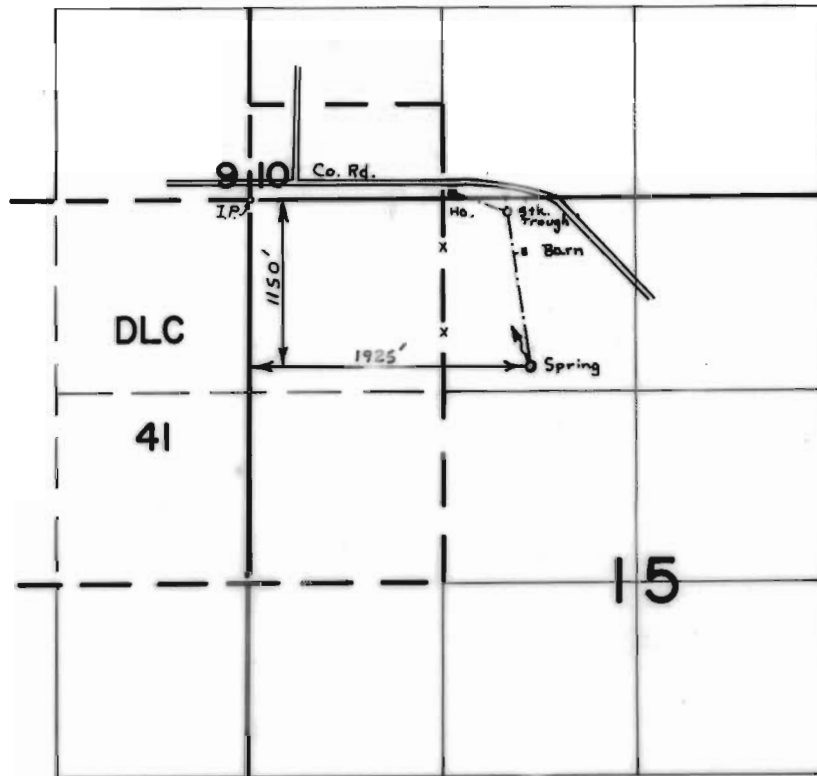

FINAL PROOF SURVEY
UNDER

Application No. 50976 Permit No. 38477
IN NAME OF

MRS. WILLIAM B. JENSEN

Surveyed MAY 21 1976, by C.R. KING