


6-2933
45574


T.3N. R.33E. W.M.

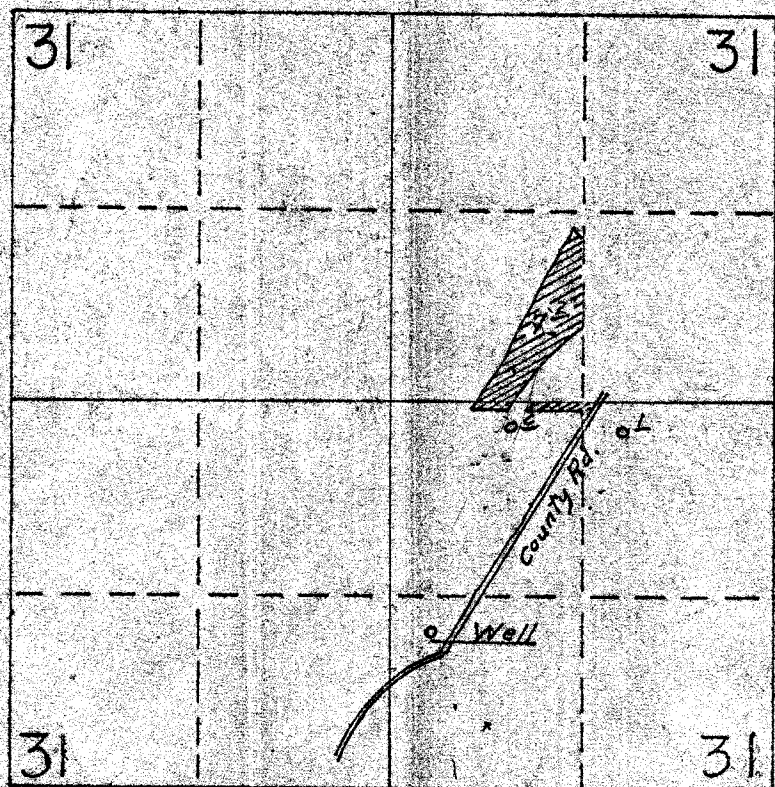

Application No. G-3138 Permit No G-2933

JAMES RUTTEN

T.3N. R.33E. W.M.

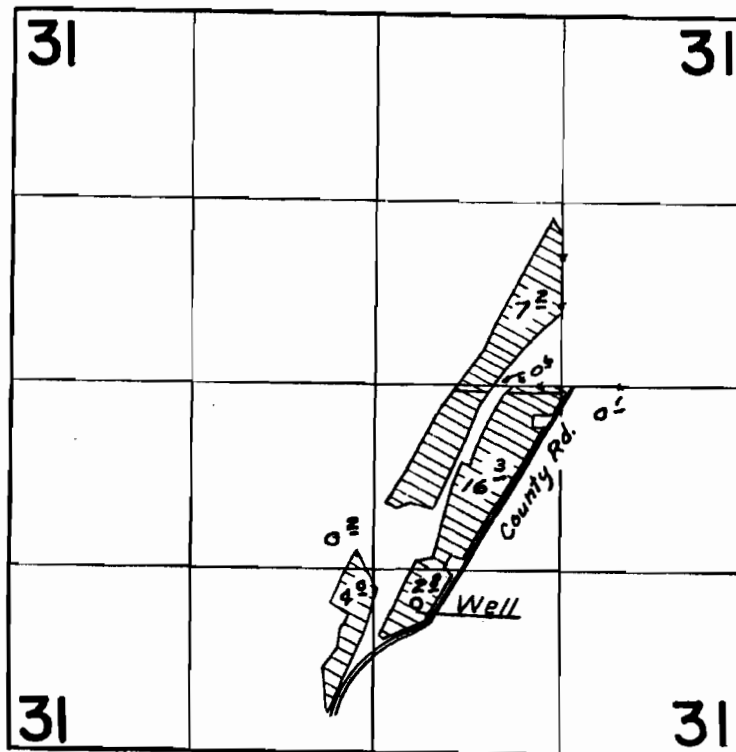

FINAL PROOF SURVEY
UNDER

Application No. G-3138 Permit No. G-2933
G-213 G-132
IN NAME OF
JAMES RUTTEN

Surveyed August 18, 1964, by C. J. Gardner
APRIL 10, 1975 L. To 11