


G-6342

45576

# T.6N.,R.36E.,W.M.

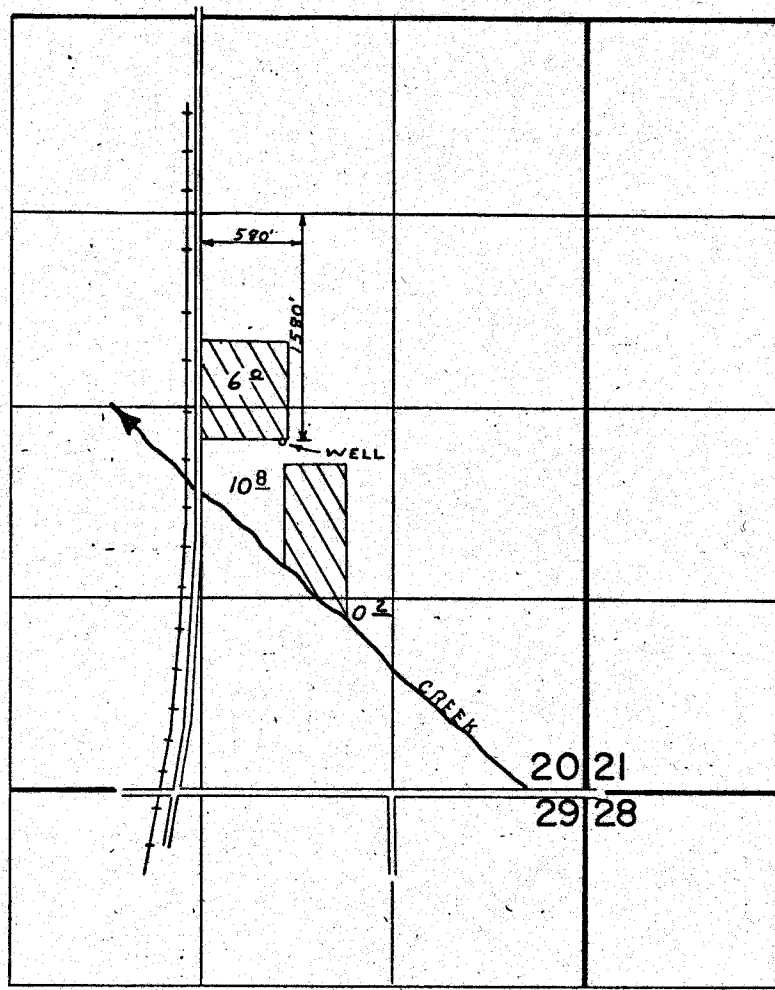

## FINAL PROOF SURVEY UNDER

Application No. G-7167... Permit No. G-6342...  
IN NAME OF

MARTIN H. & JANET A. BUCHANAN

Surveyed APRIL 9 1976, by C.R. KING