


T.6S.R.31E.W.M.

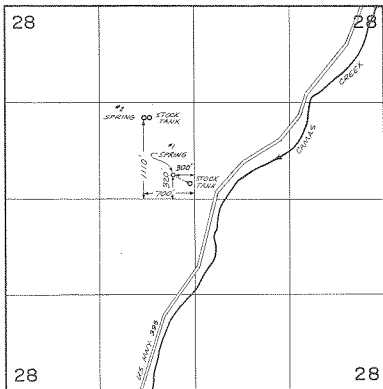

FINAL PROOF SURVEY UNDER

Application No. 42071... Permit No. 31488...

IN NAME OF

Finis Kirkpatrick et al

Surveyed APRIL 7, 1975, by D. NORBY