


G-3882

45579
41387
44224

T.6 N. R.35 E. W.M.

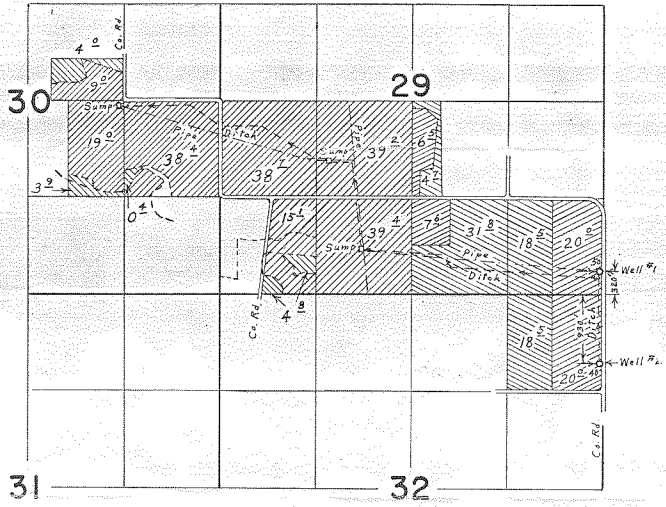

- Primary Well #1
- Supplemental Well #1
- Primary Well #2
- Supplemental Well #2

FINAL PROOF SURVEY UNDER

Application No. G-4128. Permit No. G-3882.
IN NAME OF

BURLINGAME LAND & LIVESTOCK, INC.

Surveyed Aug. 7, 1973, by L. E. Gould