


T. 1 N., R. 39 E., W.M.

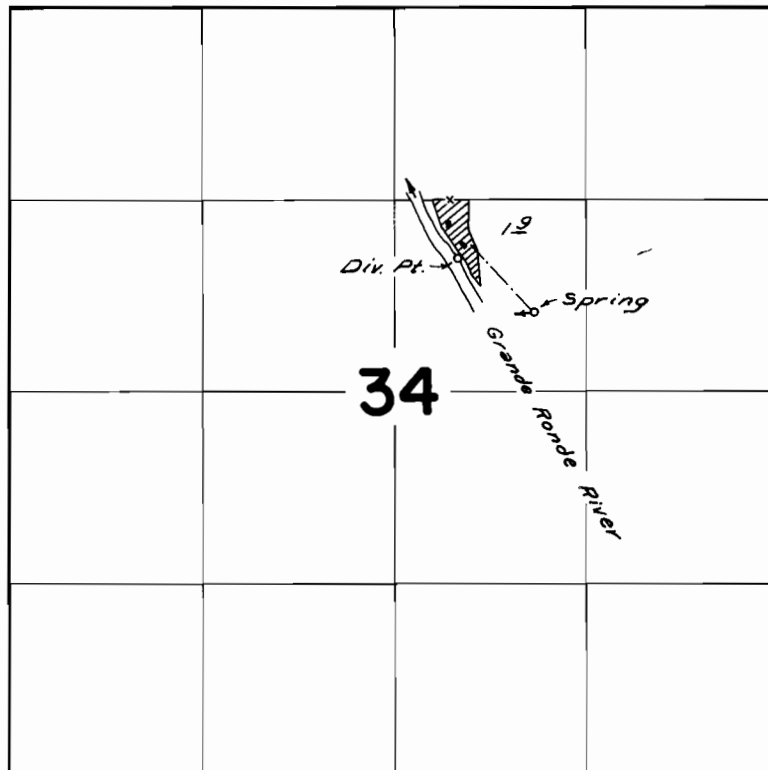

Spring Loc.: 540 H.N. & 960 H.E.  
Div. Pt. Loc.: 920 H.N. & 430 H.E. both from ctr. 1/4 Sec. 34

**FINAL PROOF SURVEY**  
UNDER

Application No. 51097 Permit No. 37144  
IN NAME OF

Howard C. Bergstrom

Surveyed Oct 26, 1976, by L. H. Nunn