


# T. 3S. R. 45E. W.M.

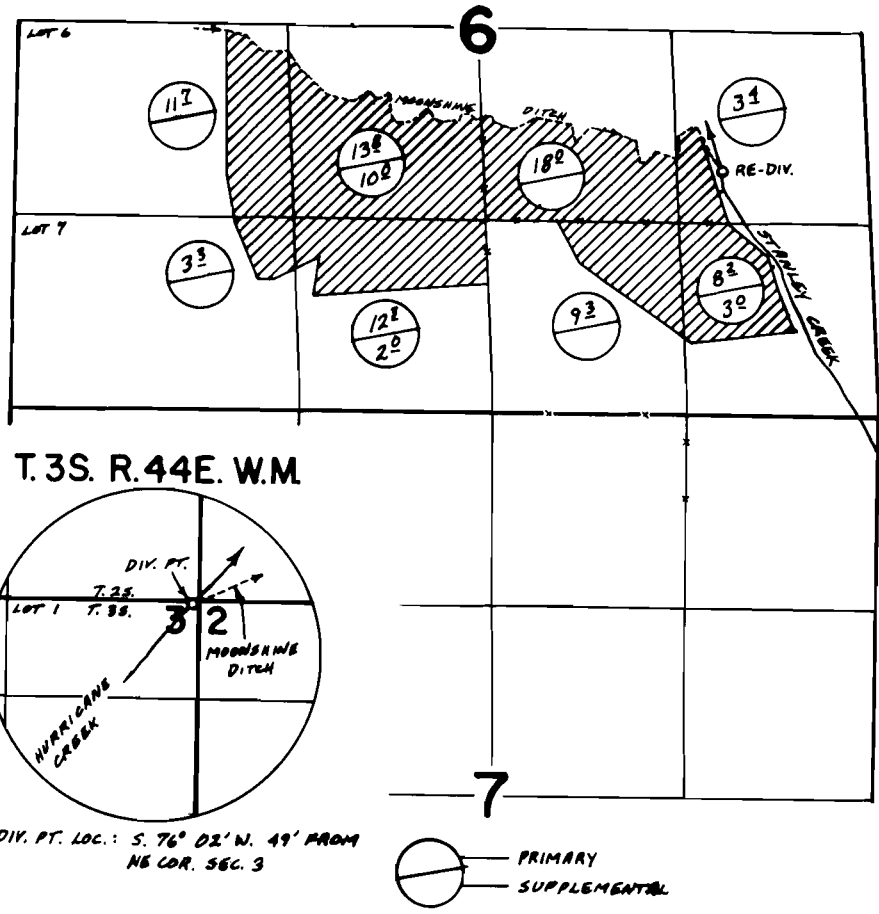

## FINAL PROOF SURVEY UNDER

Application No. 45488 Permit No. 34113  
 IN NAME OF  
DONALD F. BUHLER  
 Surveyed NOV. 5 1975, by L. H. NUNN