


T.8S. R.48E. W.M.

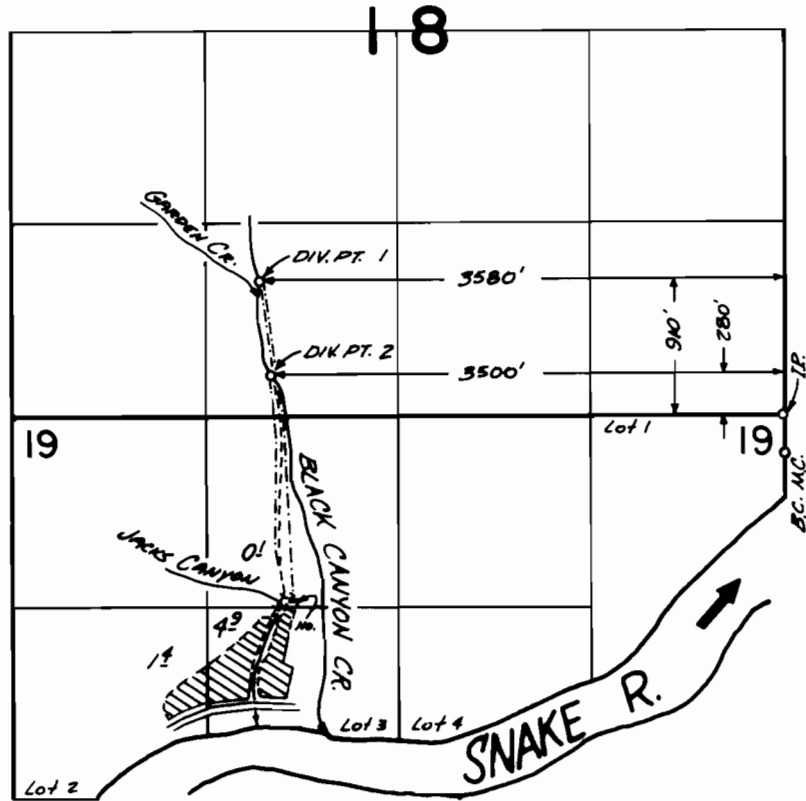

FINAL PROOF SURVEY UNDER

Application No. 47776 Permit No. 35799
IN NAME OF

MABEL H. RAY

Surveyed JUNE 17, 1976, by C.R. KING