


T.8S.R.39E.W.M.

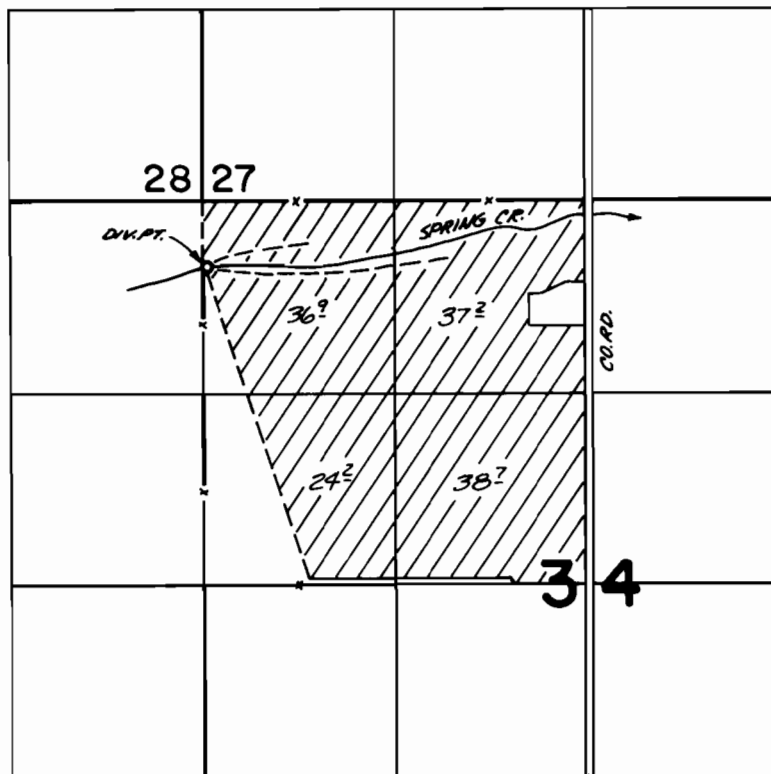

DIV. PT. 450' S. & 20' E. FROM N.W. COR. SEC. 34.

FINAL PROOF SURVEY
UNDER

Application No. 51544 Permit No. 38890
IN NAME OF

FRED J. COCKRAM

Surveyed JUNE 19 1976, by C.R. KING