


T. 9S., R. 43E., W.M.

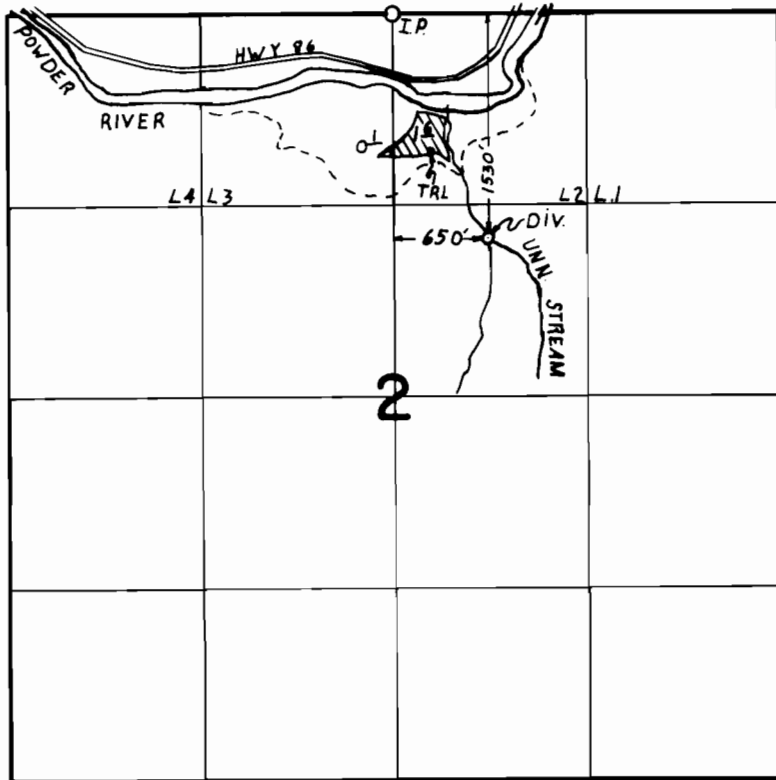

FINAL PROOF SURVEY
UNDER

Application No. 49086 Permit No. 36332
IN NAME OF

WILLIAM R. CLINE

Surveyed JUNE 17, 1976, by C.R. KING