
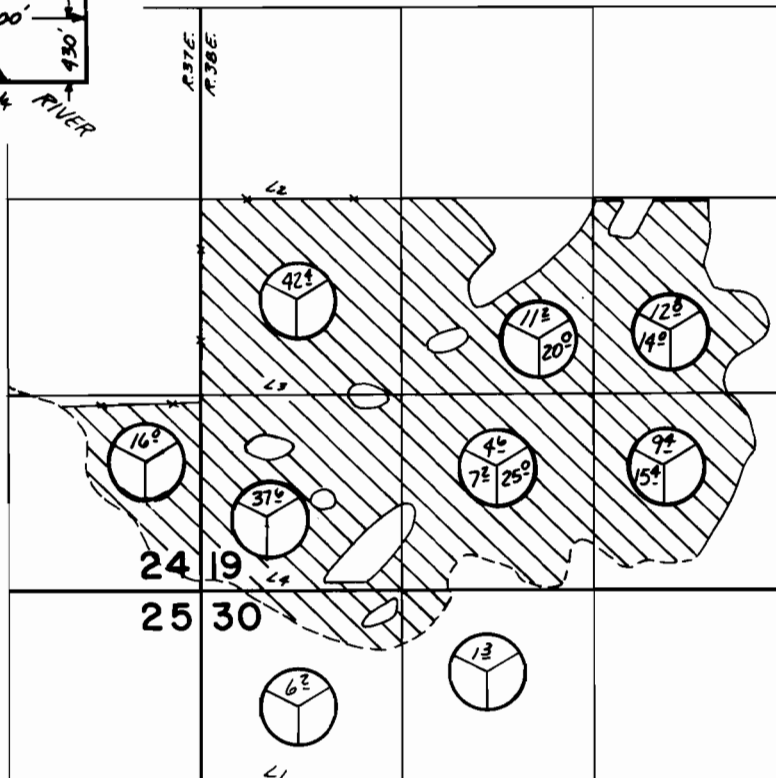


T. 10 S. R. 37 & 38 E. W.M.

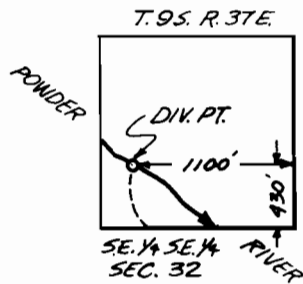

PRIMARY

OLD RIGHTS

SUPP.

FINAL PROOF SURVEY UNDER

Application No. 40399 Permit No. 30124
IN NAME OF

SETH DENNIS

Surveyed AUG. 26. 1975, by R. G. MUCKEN