


T.10S. R.6 W. W.M.

SEC. 26

1" = 400'

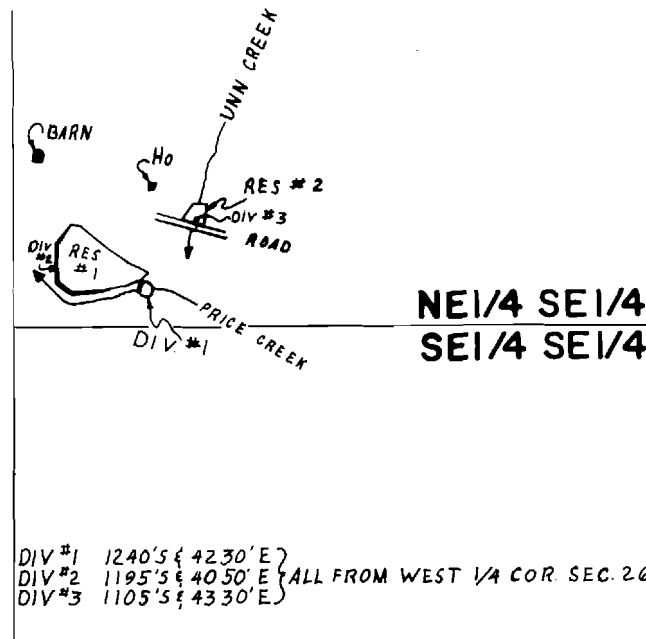

FINAL PROOF SURVEY UNDER

Application No. R-48508 Permit No. R-5889
48509 36396
IN NAME OF

PUBLISHERS PAPER CO.

Surveyed OCT. 6 1976, by C.R. KING