


T. 10 S. R. 6 W. W.M.

SEC. 26

1" = 400'

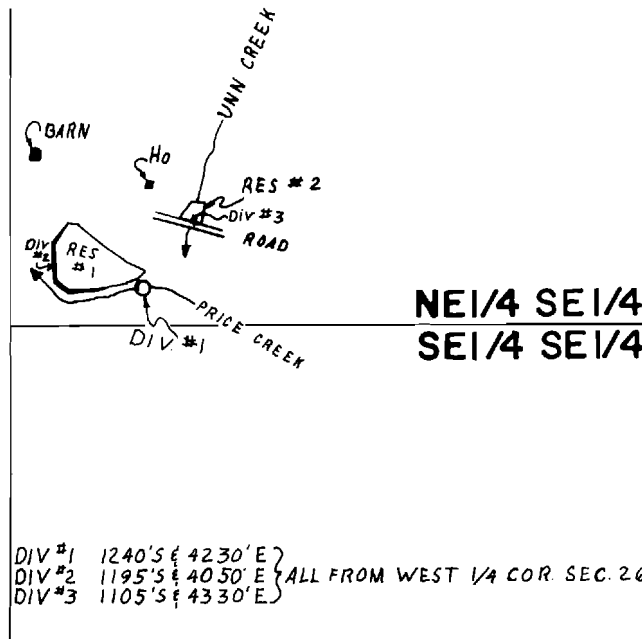

FINAL PROOF SURVEY UNDER

Application No. R-48508 48509 Permit No. R-5889 36396
IN NAME OF

PUBLISHERS PAPER CO.

Surveyed OCT. 6 1976, by G.R. KING