


T.12S.,R.6W.,W.M.

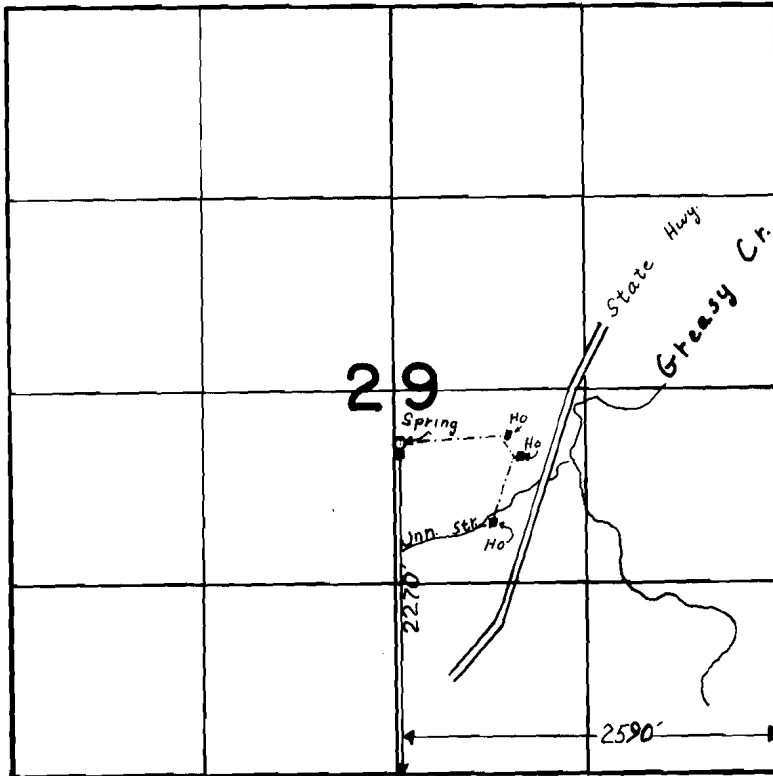

FINAL PROOF SURVEY
UNDER

Application No. 53642 Permit No. 40122
IN NAME OF

WILLIAM ARCHIE STURDEVANT.

Surveyed OCT. 5, 1976, by G.R. KING