


T.3 S. R.1 E. W.M.

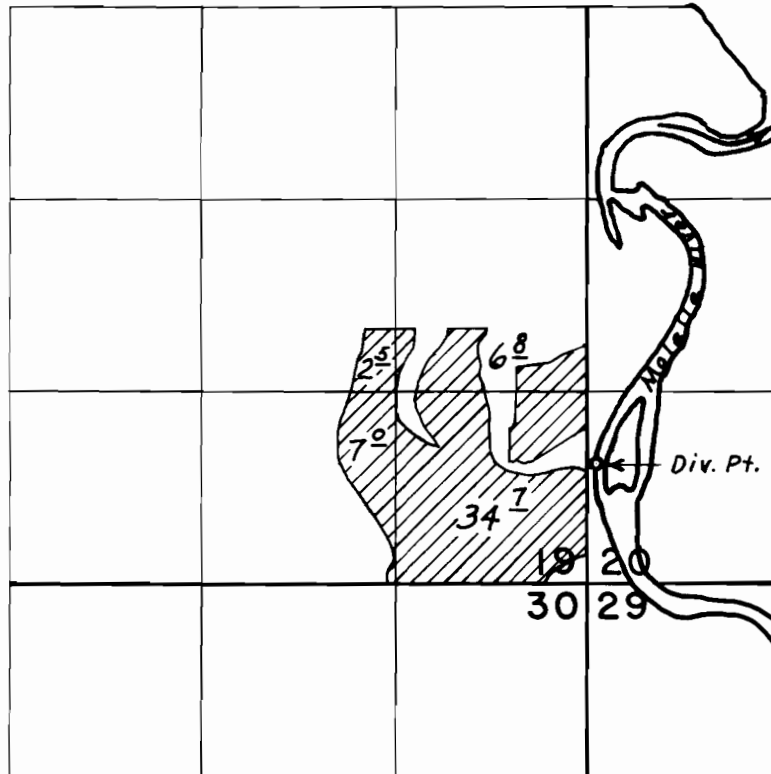

Div. Pt. located 820' N. & 60' E. from S.W. Cor. Sec. 20

FINAL PROOF SURVEY
UNDER

Application No. 51608... Permit No. 38925...
IN NAME OF

EDWARD J. MALIN

Surveyed April 23, 1976, by L. E. Gould.