


T.6 S. R.1 E. W.M.

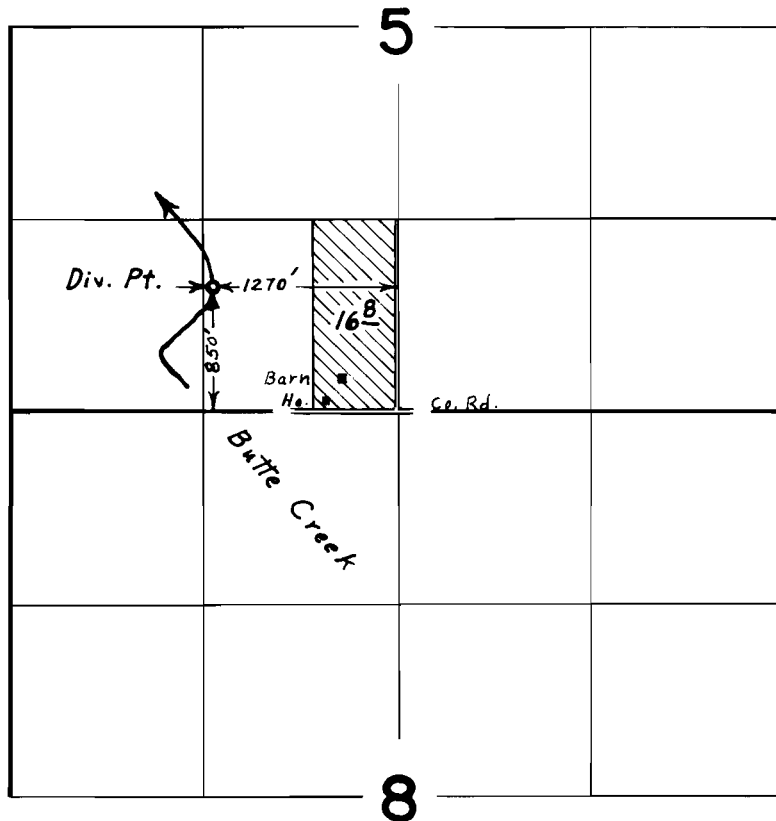

**FINAL PROOF SURVEY**  
UNDER

Application No. 52315... Permit No. 39352.  
IN NAME OF

MIKE EUGENE KOMP

Surveyed April 2, 1976, by L. E. Gould.