


T.4 S. R.1 E. W.M.

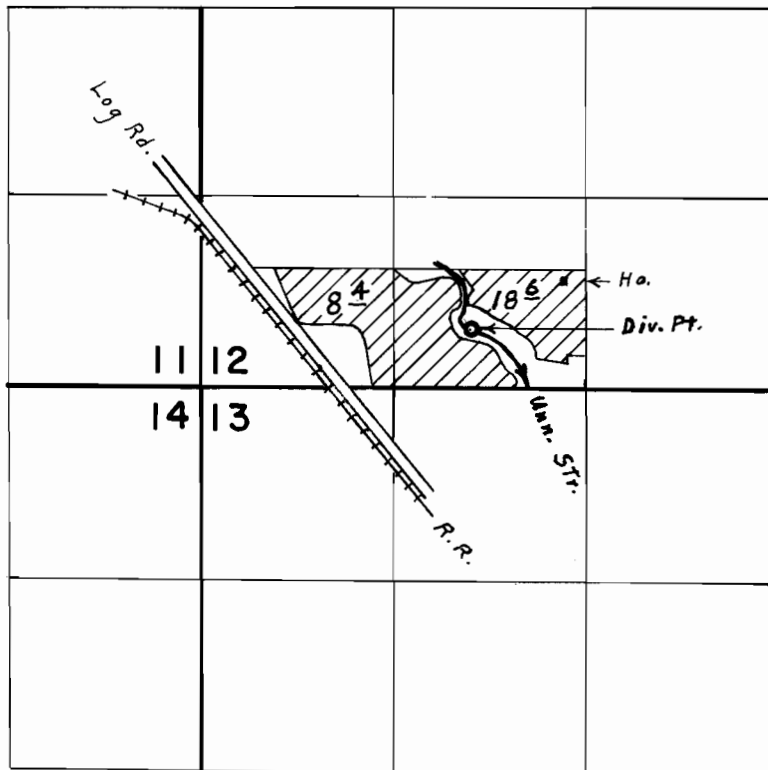

Div. Pt. located 410' N. & 1860' E. from S. W. Cor. Sec. 12

FINAL PROOF SURVEY UNDER

Application No. 52476 Permit No. 39456
IN NAME OF

LYMAN I. LELAND

Surveyed April 20, 1976, by L. E. Gould