


T.6N.,R.10W.,W.M.

SEC. 34

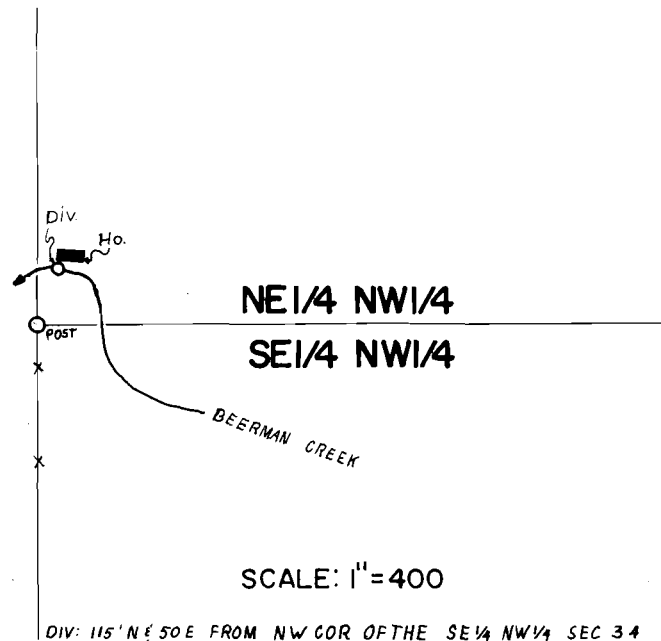

FINAL PROOF SURVEY
UNDER

Application No. 50377 Permit No. 38025
IN NAME OF

LEO J. GALASH

Surveyed SEPT. 16, 1976, by C.R. KING