


T.5N., R.10W., W.M.

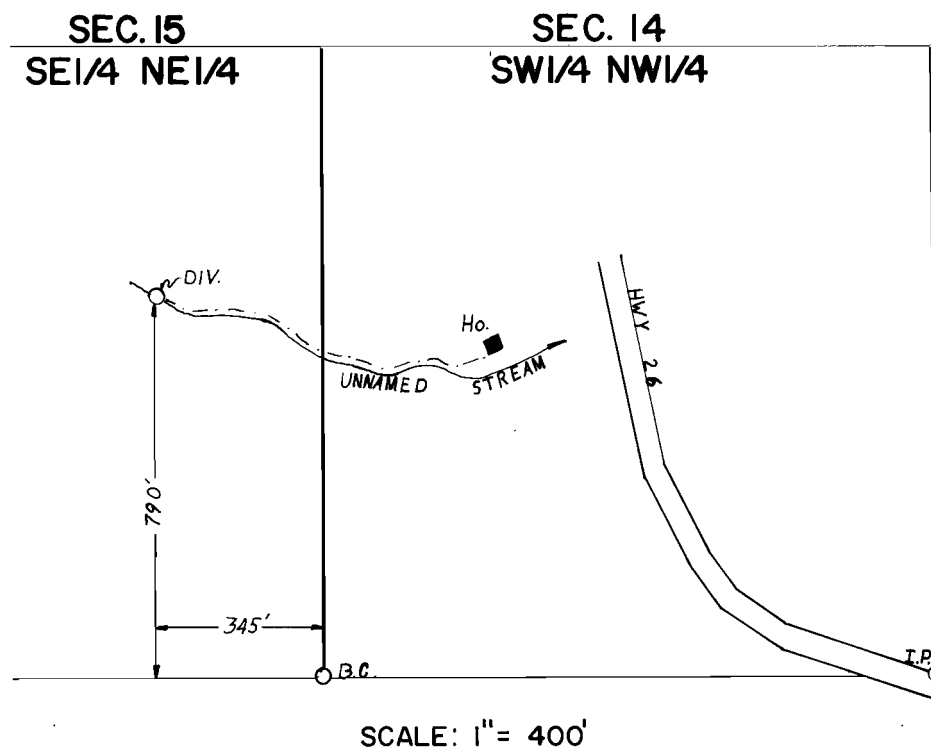

FINAL PROOF SURVEY
UNDER

Application No. 53024 Permit No. 40019
IN NAME OF

EDGAR C. BOUCHOR

Surveyed SEPT. 14, 1976, by C.R. KING