


T.29S. R.14W. W.M.

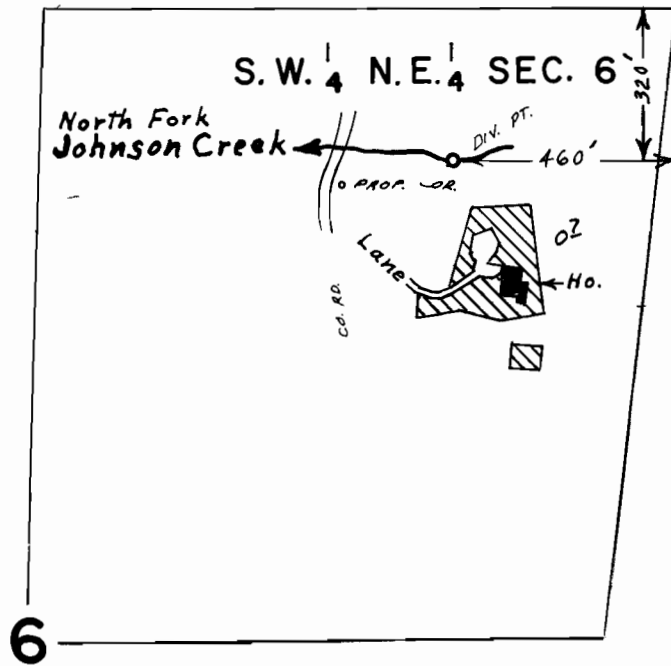

SCALE 1" = 400'

FINAL PROOF SURVEY
UNDER

Application No. 51345 Permit No. 38762
IN NAME OF

RALPH YOCKEY

Surveyed July 21, 1976, by L. E. Gould