


T. 35 S. R. 14 W. W. M.

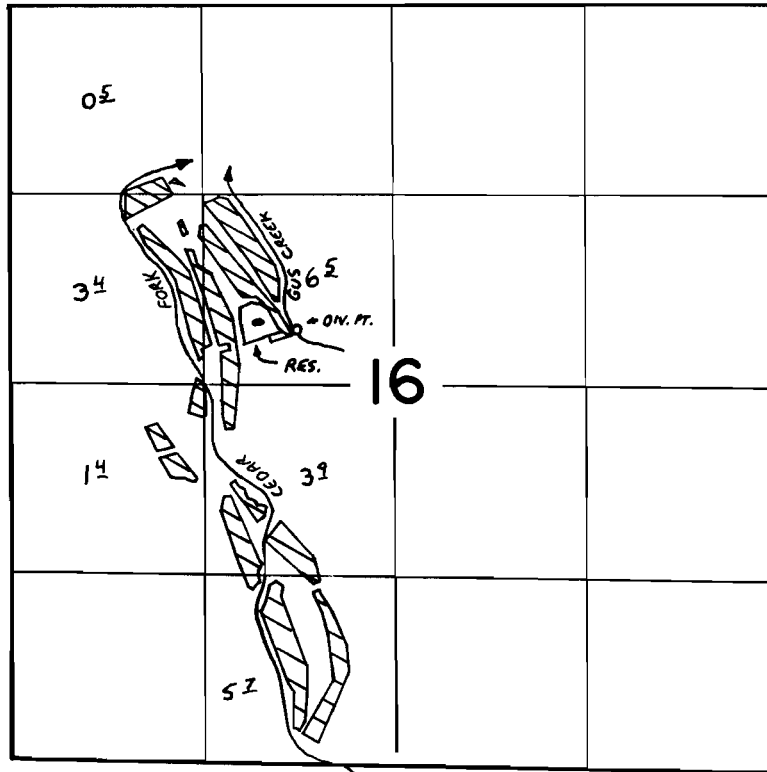

DIVERSION POINT LOCATED : 370' N & 640' E FROM THE SW COR SE 1/4 NW 1/4

FINAL PROOF SURVEY
UNDER

Application No. R-52773 52524 Permit No. R-6272 39169
IN NAME OF

CEDAR BEND GOLF ASSOCIATION, INC.

Surveyed OCT. 26 1976, by L. E. GOULD