


T. 35 S. R. 14 W. W.M.

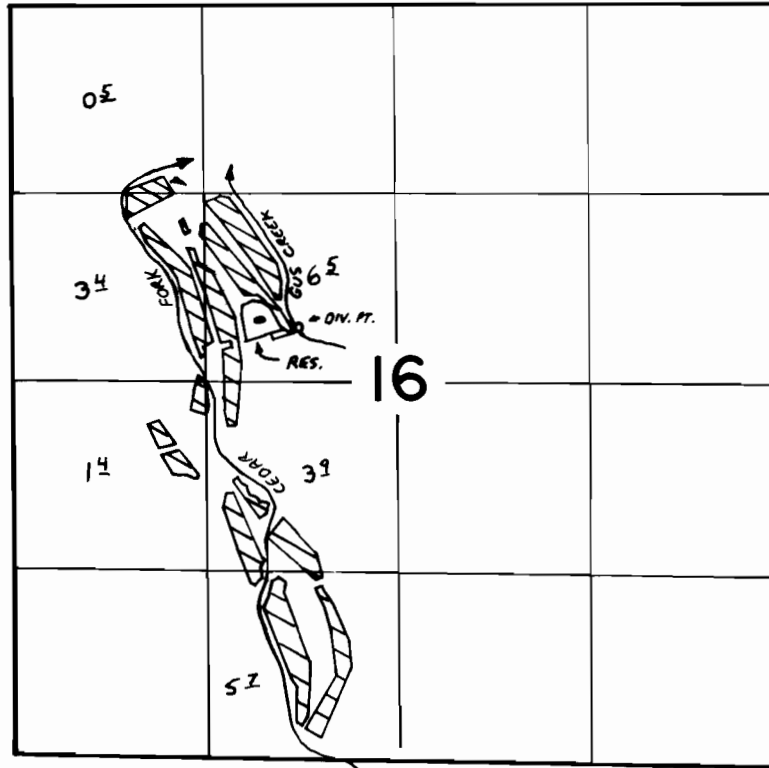

DIVERSION POINT LOCATED : 370' N & 640' E FROM THE SW COR SE 1/4 NW 1/4

FINAL PROOF SURVEY
UNDER

Application No. ^{R-52773} 52524..... Permit No. ^{R-6272} 39169.....
IN NAME OF

CEDAR BEND GOLF ASSOCIATION, INC.

Surveyed OCT. 26 1976, by L.E. GOULD.....