


T.23S.R.5W.W.M.

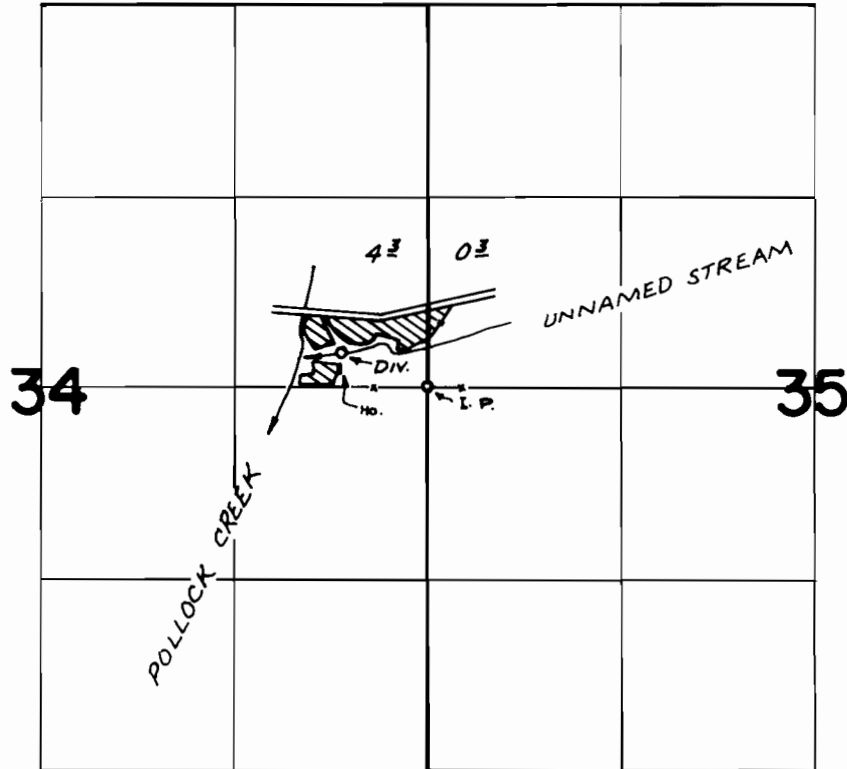

DIV. LOC: 230' N. & 390' W. FROM W $\frac{1}{4}$ COR. SEC. 34

FINAL PROOF SURVEY
UNDER

Application No. 49039 Permit No. 36699
IN NAME OF

ROBERT E. TAYLOR

Surveyed MAY 14, 1976, by R. MUCKEN