


T.29S. R.6W. W.M.

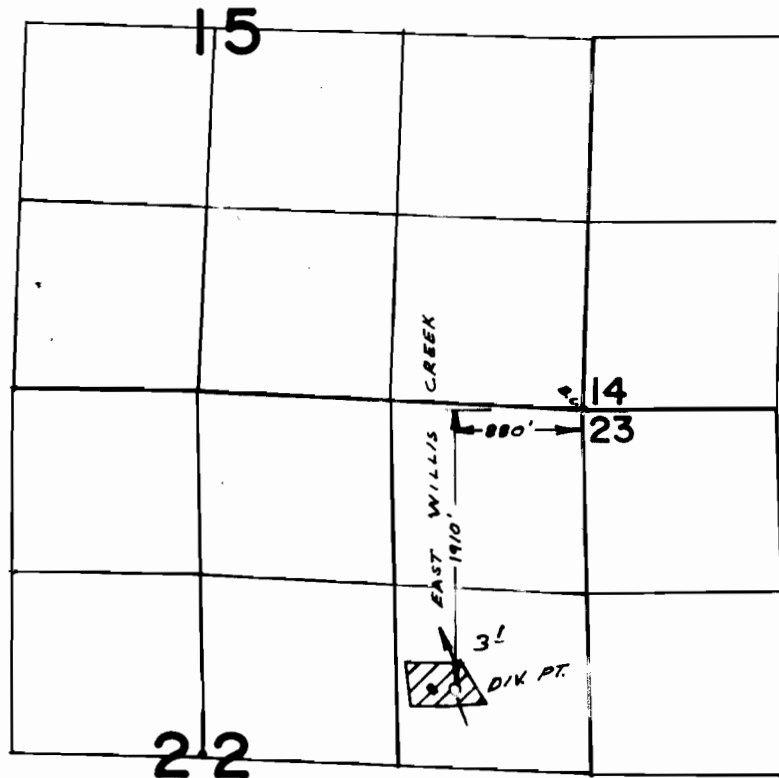

FINAL PROOF SURVEY
UNDER

Application No. 49317 Permit No. 36975
IN NAME OF

J. JAMES JONES

Surveyed OCT. 6 1976, by L.H. NUNN