


T.29S. R.4&5W. W.M.

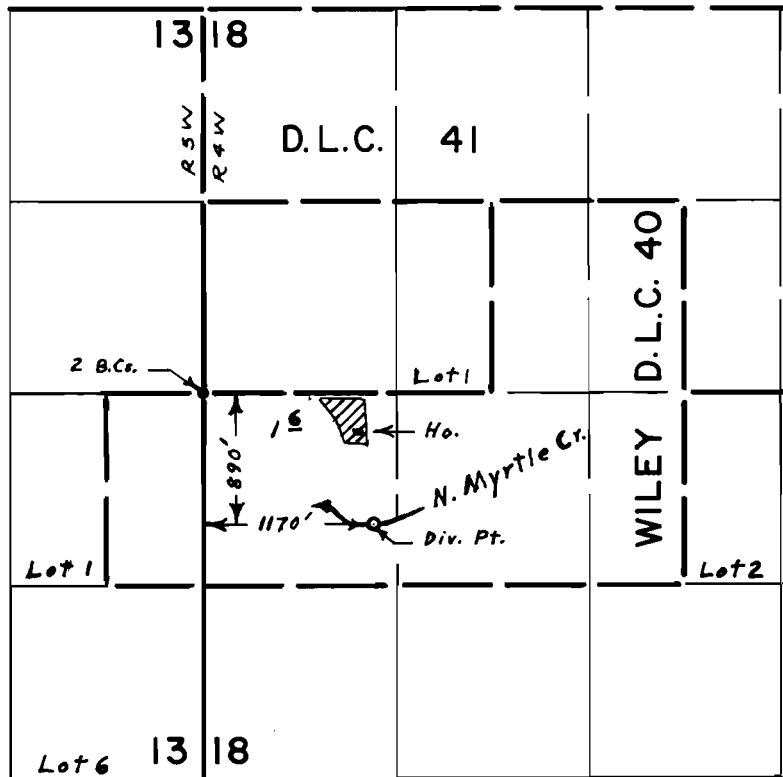

FINAL PROOF SURVEY
UNDER

Application No. 50147 Permit No. 37676
IN NAME OF

MAROLD GLENN HAYTER

Surveyed May 27, 1976, by L. E. Gould