


T. 25 S. R. 7 W. W.M.

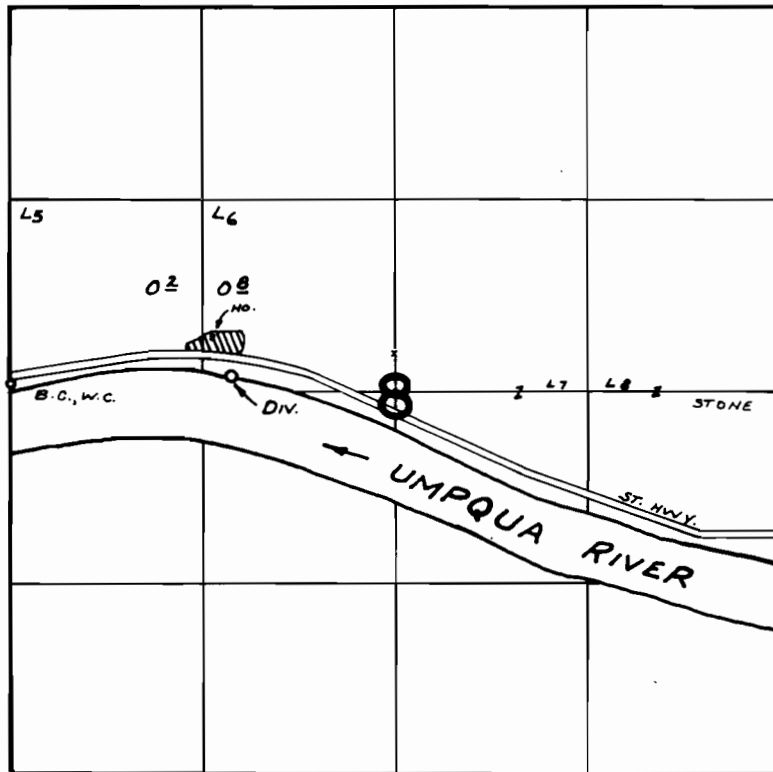

DIV. LOC: 100' N. & 1520' E. FROM W. $\frac{1}{4}$ COR. SEC. 8

FINAL PROOF SURVEY
UNDER

Application No. 59/72 Permit No. 37913
IN NAME OF

BRYON NEYLE FISH

Surveyed MAY 28 1976, by R. MUCKEN